


# T. 38 S., R. 3 W., W.M.

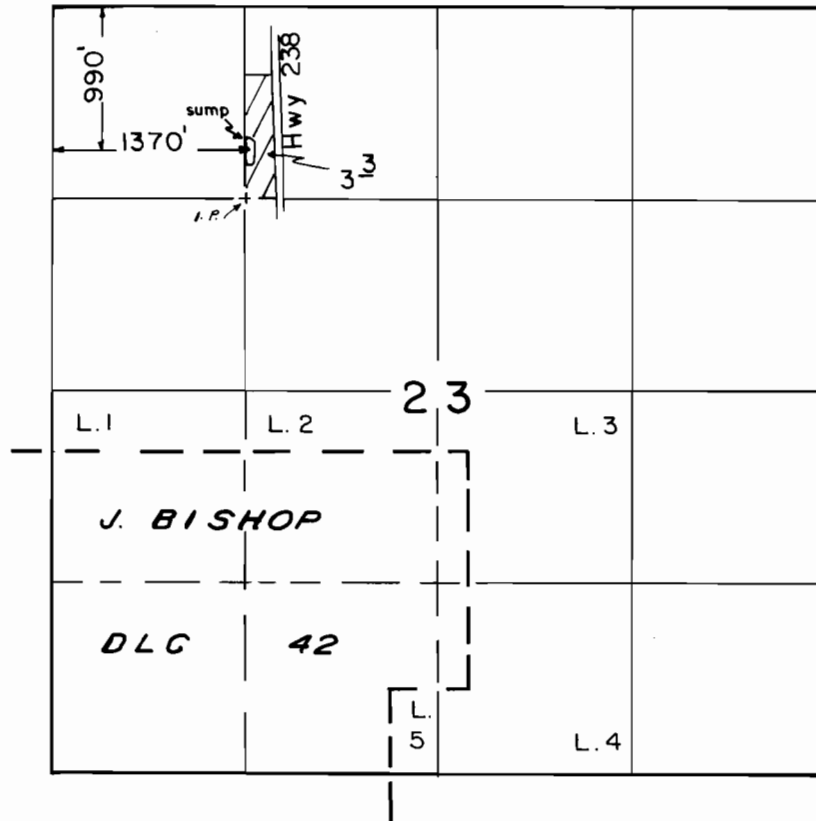

Scale: 1" = 1320'

## FINAL PROOF SURVEY UNDER

Application No. G-10863... Permit No. G-10053...  
IN NAME OF

JACK LEACH

Surveyed Q.C.T...2... 19.8.9, by L. JOACHIMS....