


T. 36 S., R. 5 W., W. M.

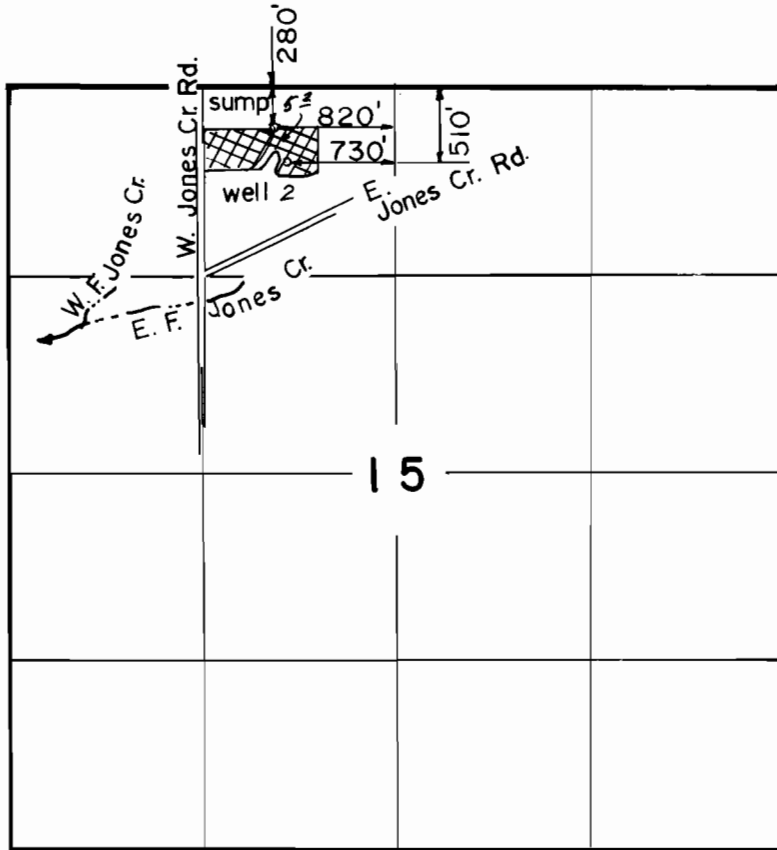

Scale: 1" = 1320'

FINAL PROOF SURVEY
UNDER

Application No. G-11034 Permit No. G-10198.
IN NAME OF

STEPHEN FREDERICK COUNTS

Surveyed AUG. 3, 1987, by B. S. JAMES