


T. 37 S., R. 5 W., W. M.

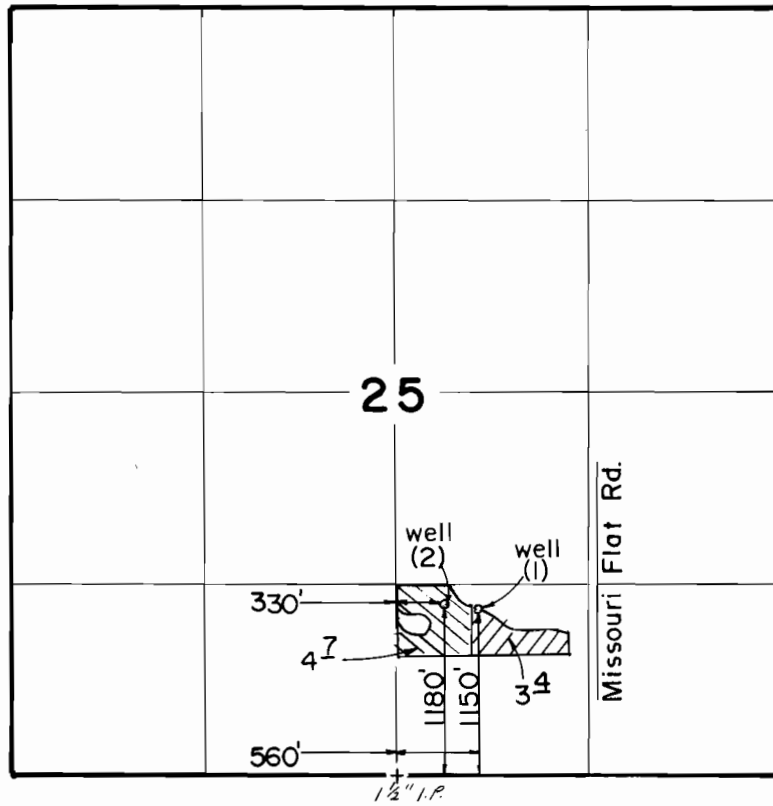

Scale: 1" = 1230'

FINAL PROOF SURVEY
UNDER

Application No. G-11041 Permit No. G-10204
IN NAME OF

LAWRENCE L. & INGE BORG STONEQUIST

Surveyed AUG. 23. 19.8.8, by B.....S.....JAMES..