


T. 28S., R. 6W., W.M.

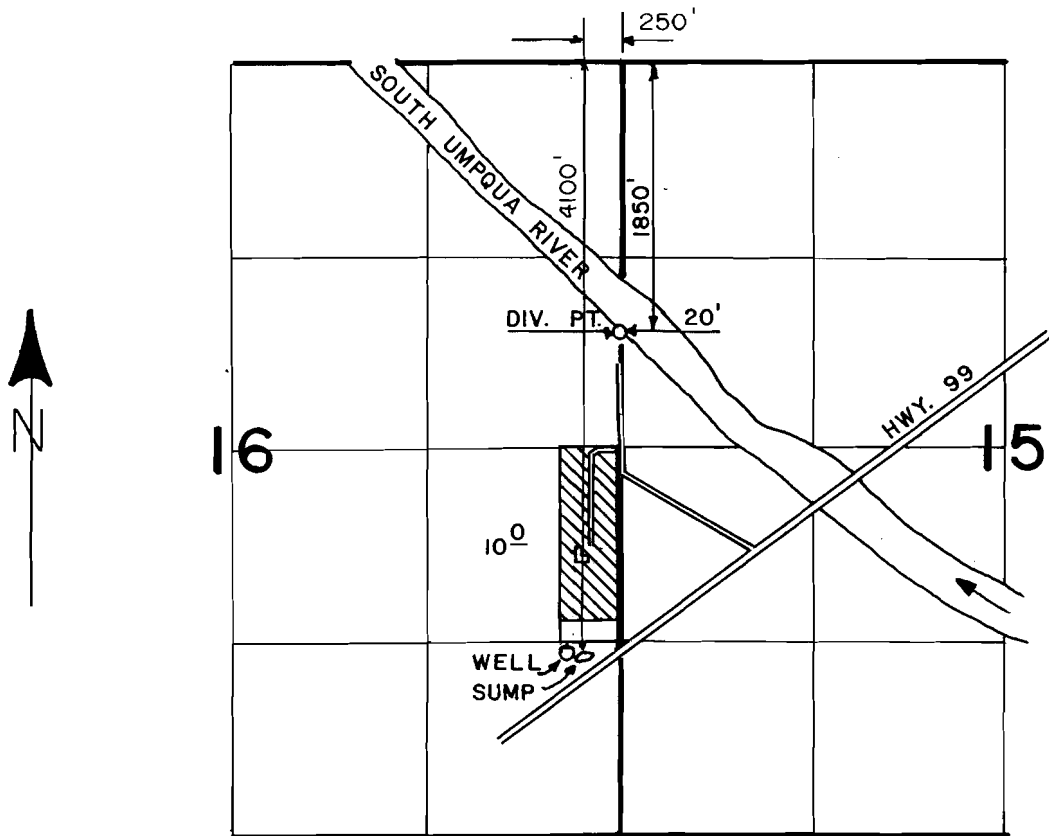

SCALE: 4" = 1 MILE

FINAL PROOF SURVEY
UNDER

G- 11057 G- 10213
Application No. 65583 Permit No. 47998.....
IN NAME OF

SPARKY L. TURNER

Surveyed NOV. 3, 1987, by J. M. SCHMORDE