


# T. 36 S., R. 4 W., W. M.

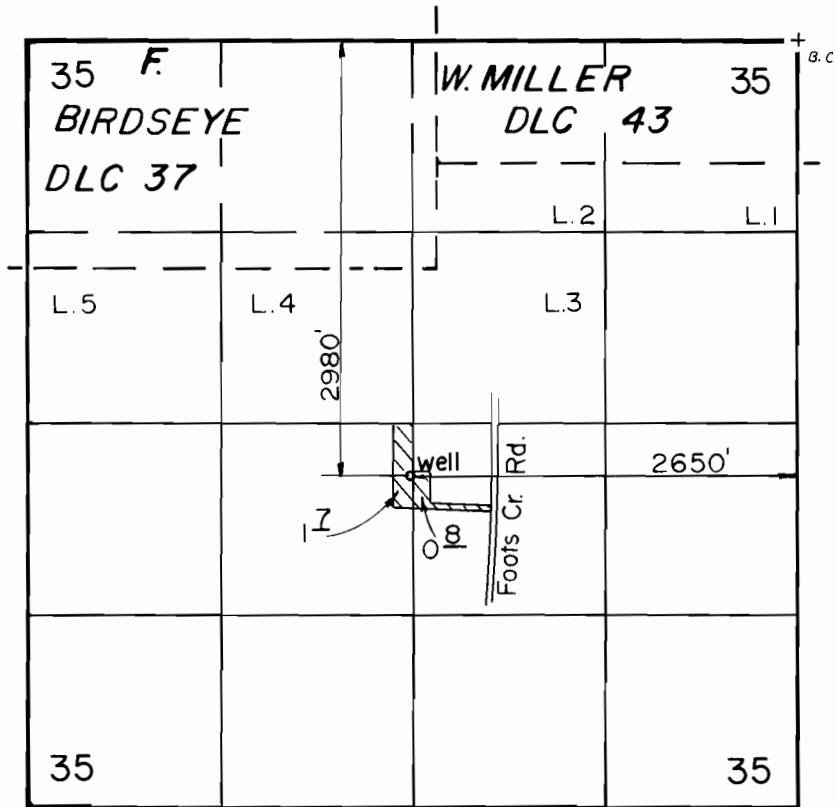

Scale: 1" = 1320'

## FINAL PROOF SURVEY UNDER

Application No. G-11098 Permit No. G-10346...  
IN NAME OF

JACK E. CROMER

Surveyed FEB. 10. 1988, by B. S. JAMES...