


T. 36 S., R. 4 W., W. M.

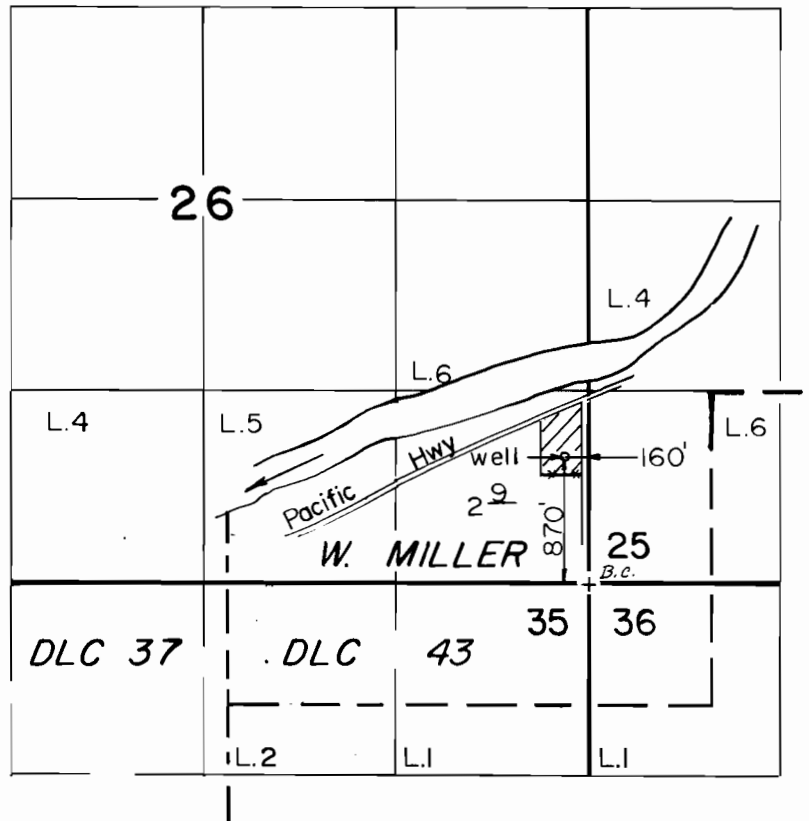

FINAL PROOF SURVEY UNDER

Application No. G-11129. Permit No. G-10290
IN NAME OF

WALTER M. & PEGGY RUTH CROMER

Surveyed FEB. 10. 1988., by B. S. JAMES.