


T. 38 S., R. 5 W., W. M.

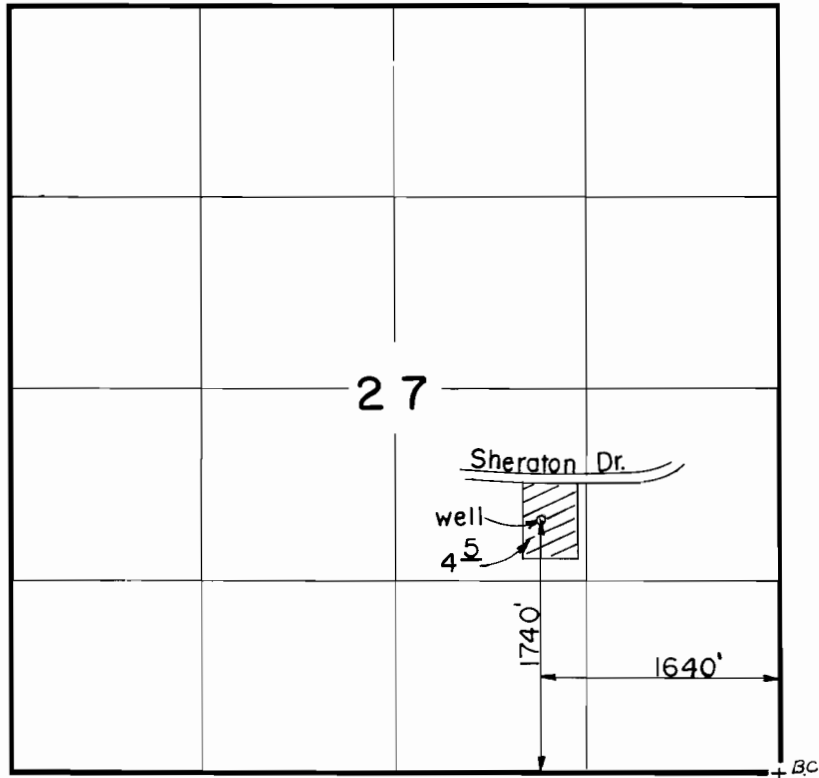

Scale: 1" = 1320'

FINAL PROOF SURVEY

UNDER

Application No. G-11153. Permit No. G-10269
IN NAME OF

T. R. TRULL & CANDACE M. MORASCH

Surveyed AUG. 8. 1988, by B. S. JAMES