


T. 39 S., R. 5 W., W. M.

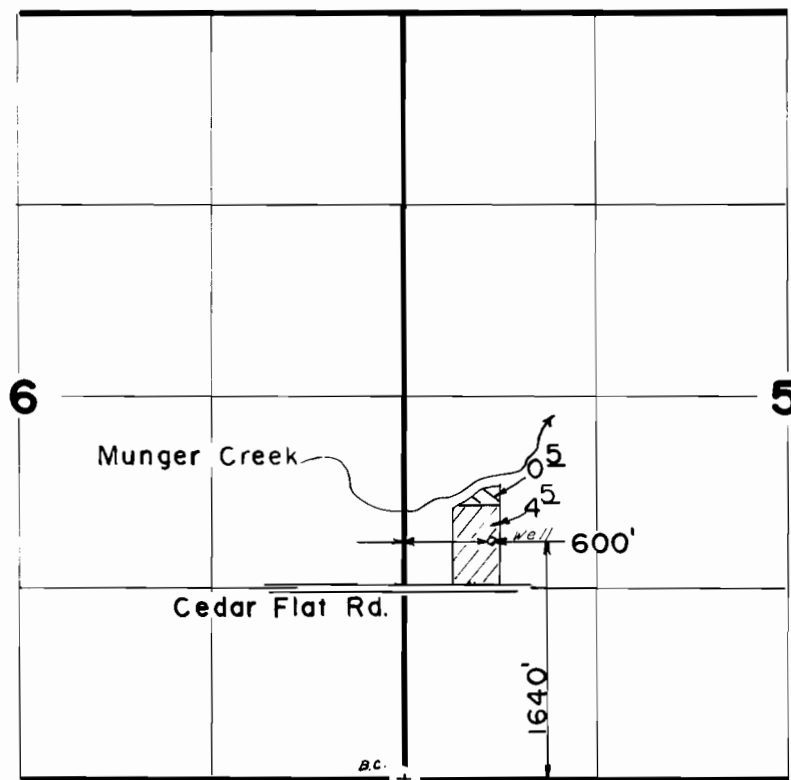

Scale: 1" = 1320'

Primary



Supplemental



FINAL PROOF SURVEY UNDER

Application No. G-11172 Permit No. G-10373
IN NAME OF

J. R. BLACK

Surveyed JUL. 11. 1988, by B. S. JAMES