


T.27S., R.18E., W.M.

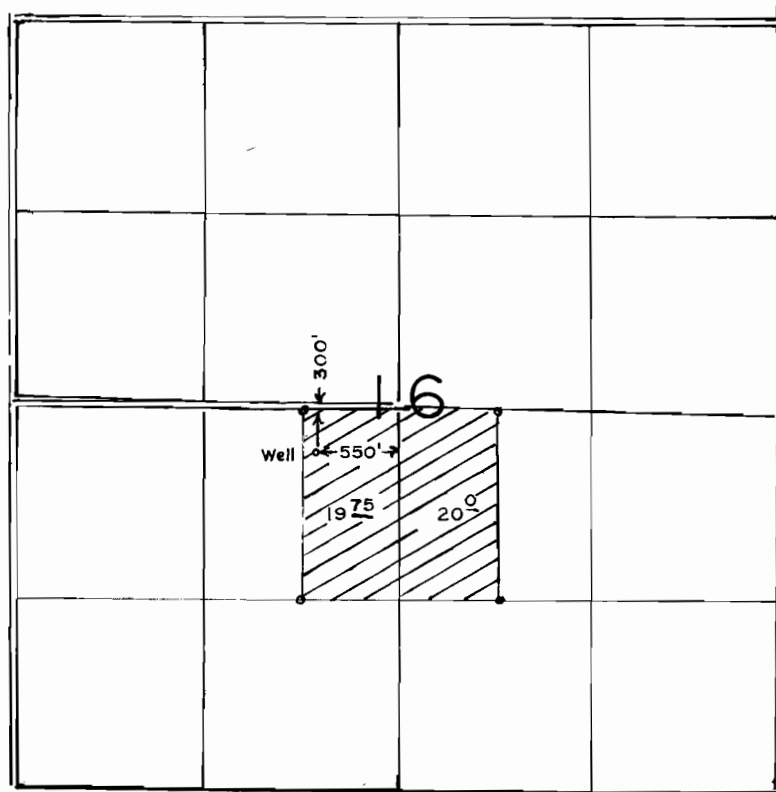

SCALE: 1"=1320'

FINAL PROOF SURVEY
UNDER

Application No. G-11203. Permit No. G-10704...
IN NAME OF

.....**John H. & Patricia E. Effingham**.....

Surveyed JUNE 5, 1990, **by** B.W. BISHOP.....