
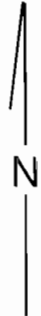


# T. 40 S., R. 7 & 8 W., W. M.

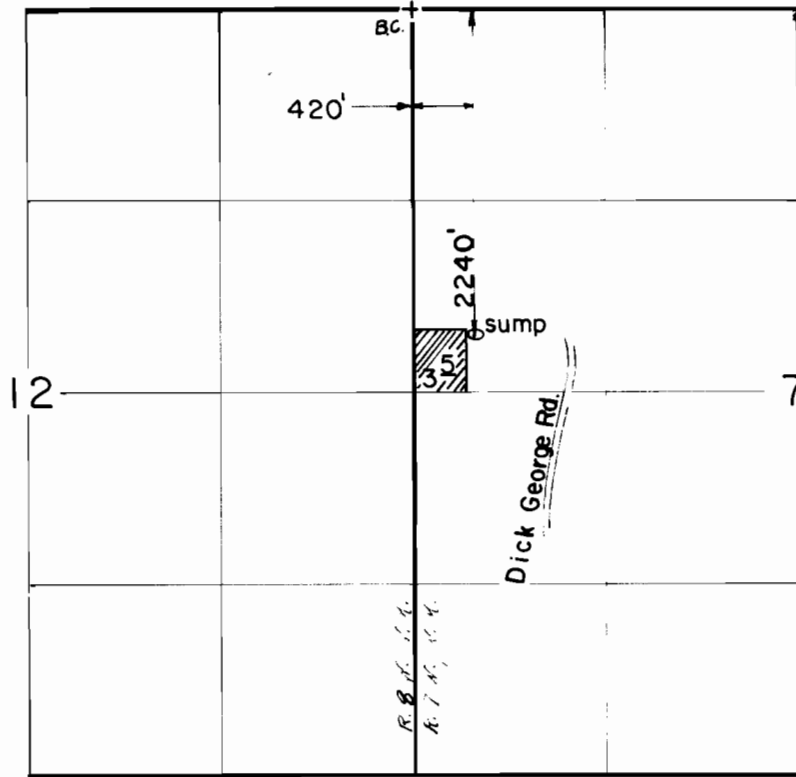

Scale: 1" = 1320'

## FINAL PROOF SURVEY UNDER

G-11346                      G-10477  
 Application No. G-11413    Permit No. G-10519  
 IN NAME OF

WILLIAM LLOYD WENDOVER

Surveyed APR. 12... 19.88, by B...S... JAMES....