


T.4S., R.1W., W. M.

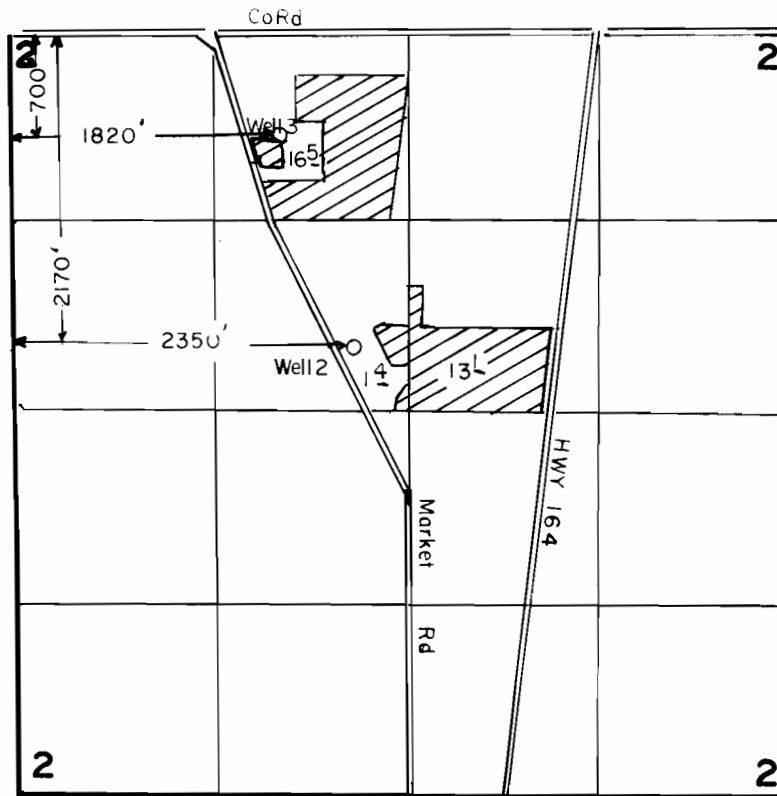

SCALE: 1" = 1320'

# **FINAL PROOF SURVEY** UNDER

Application No. G-11425... Permit No. G-10532....  
IN NAME OF

.....**SHEPHARD**.....**AZALEAS**.....

Surveyed AUG. 23.... 1989., by R.W. KLASSEN.....