


T. 36 S., R. 4 W., W. M.

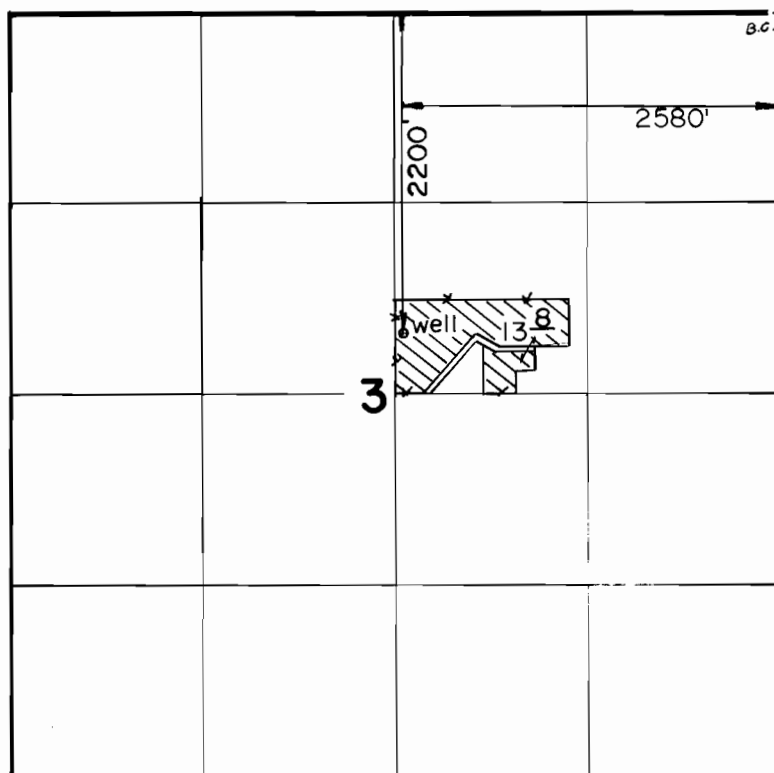

Scale: 1" = 1320'

FINAL PROOF SURVEY UNDER

Application No. G-11460. Permit No. G-10566....
IN NAME OF

.....**WILLIAM G. HILTON**.....

Surveyed FEB. 10... 1988, by B.S. JAMES...