


# T. 6 S., R. 4 & 5 W., W.M.

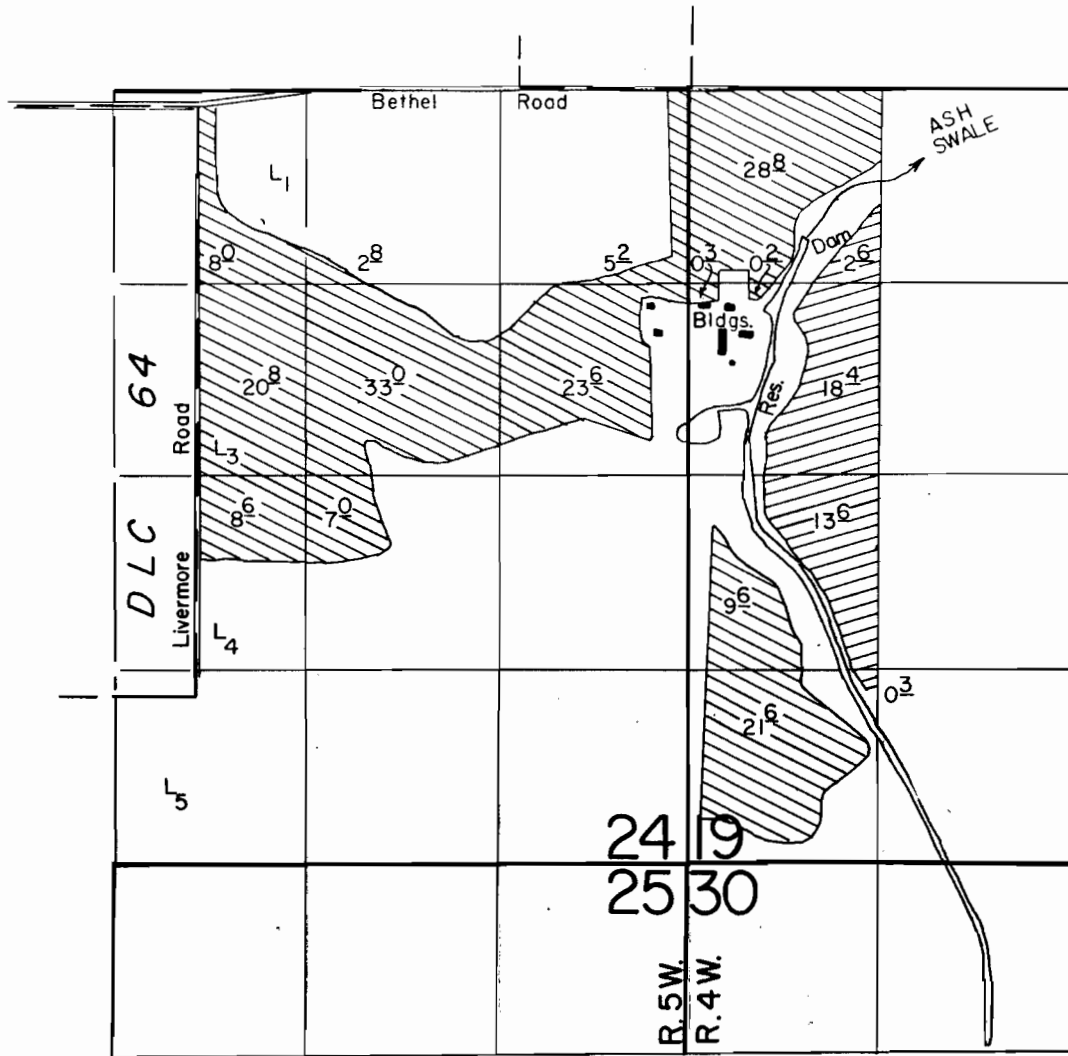

P.O.D. Loc.: 1000' S. & 800' E. from N.W. Cor. Sec. 19

Scale: 1" = 1320'

## FINAL PROOF SURVEY UNDER

R-63575                      R-8399  
63576                      46669

Application No. 68088... Permit No. 48546...



IN NAME OF

### JOHN EDWARD SCHARF

Surveyed JUNE 16 1989, by T. WARREN  
& Oct. 26, 1989

41053-178-14L

1/17/89 TMW