


T. 6 S., R. 4 & 5 W., W.M.

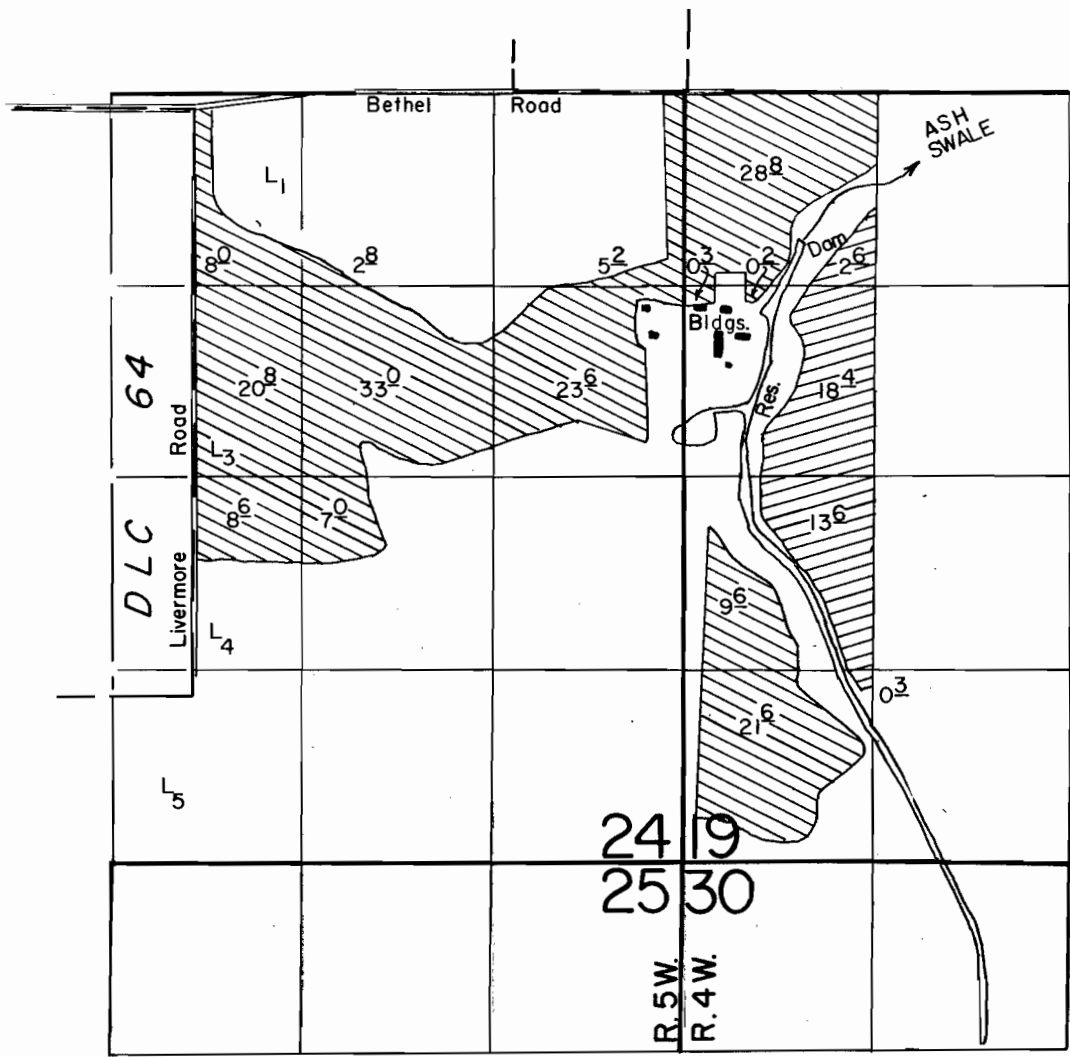

P.O.D. Loc.: 1000' S. & 800' E. from N.W. Cor. Sec. 19

Scale: 1" = 1320'

FINAL PROOF SURVEY UNDER

R-63575 R-8399
63576 46669

Application No. 68088... Permit No. 48546...

IN NAME OF

JOHN EDWARD SCHARF

Surveyed JUNE 16, 1989, by T. WARREN
& Oct. 26, 1989

