



T.1S., R.43E., W.M.

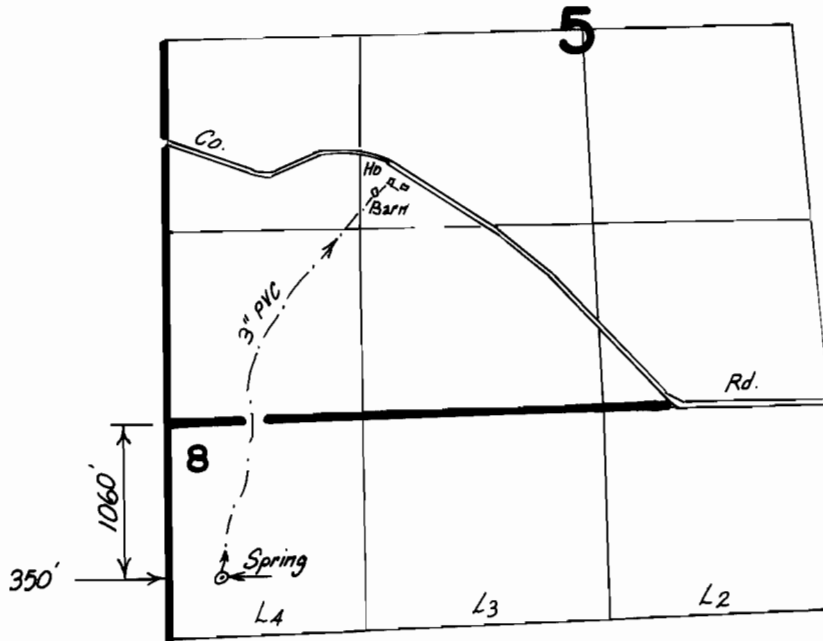

FINAL PROOF SURVEY UNDER

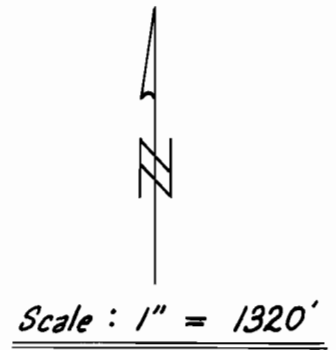

Application No. **56574** Permit No. **42468**..
IN NAME OF

.....**TED O. SORENSEN**.....

Surveyed **8-18** 19**88**, by **Vern Church**.....