


T. 4S., R. 40E., W.M.

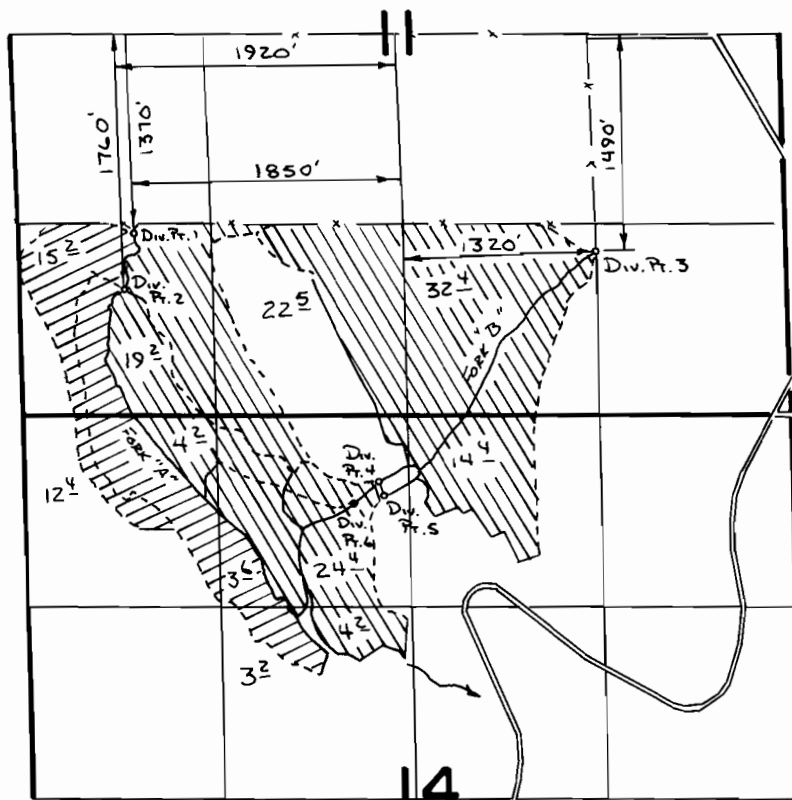

Div. Pt. 4 Loc: 450' S. & 200' W.
 Div. Pt. 5 Loc: 550' S. & 160' W.
 Div. Pt. 6 Loc: 610' S. & 380' W. } FROM N 1/4 CORNER SECTION 14

FINAL PROOF SURVEY UNDER

SCALE 1" = 1320'



Fork "A"



Fork "B"

Application No. **57836** Permit No. **43724**
 IN NAME OF

ROBERT G. SHEEHY

Surveyed 11-2-1987, by *V.L. Church*