


T.16S.,R.6W.,W.M.

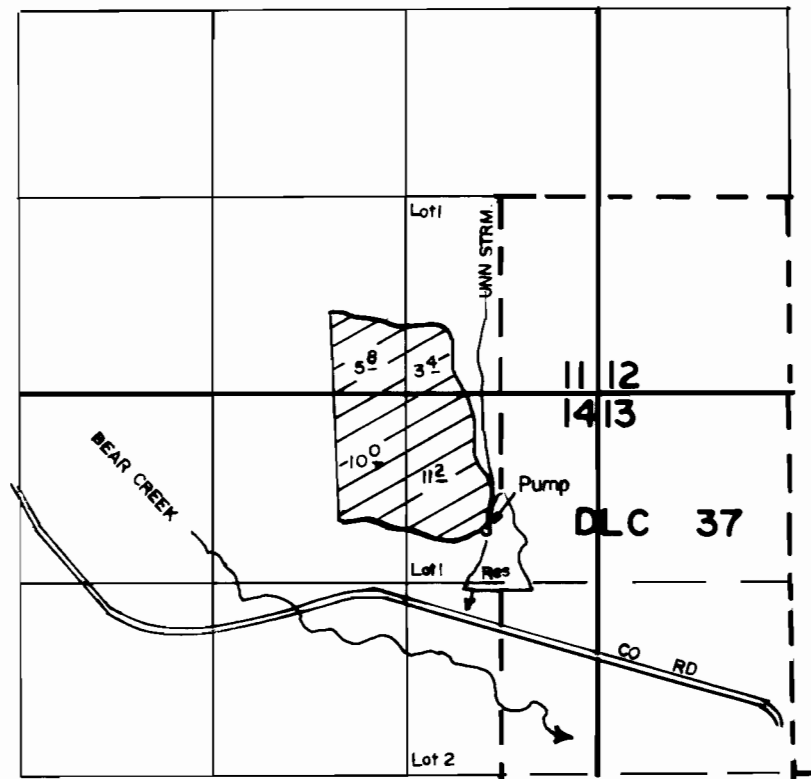

Div Pt Loc 1330' S & 850' W From NE Corner Of Section 14, T.16S., R.6W., W.M.

SCALE: 1"=1320'

FINAL PROOF SURVEY UNDER

Application No. 57847.... Permit No. 43817.....
IN NAME OF

MICHAEL R. & MERRY L. FIX.....

Surveyed MAY 9..... 1984, by P.R. PAGTER.....
APRIL 21 1988 TM WARREN