

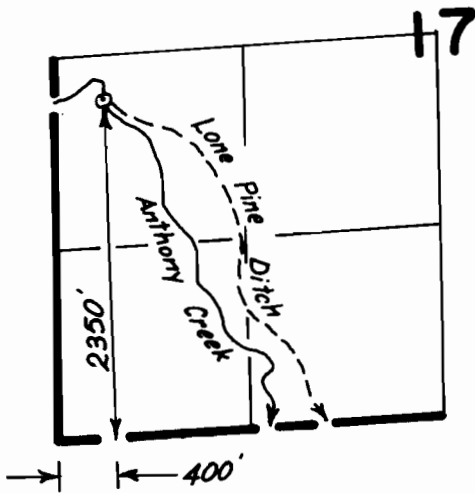


T.6S., R.38E., W.M.

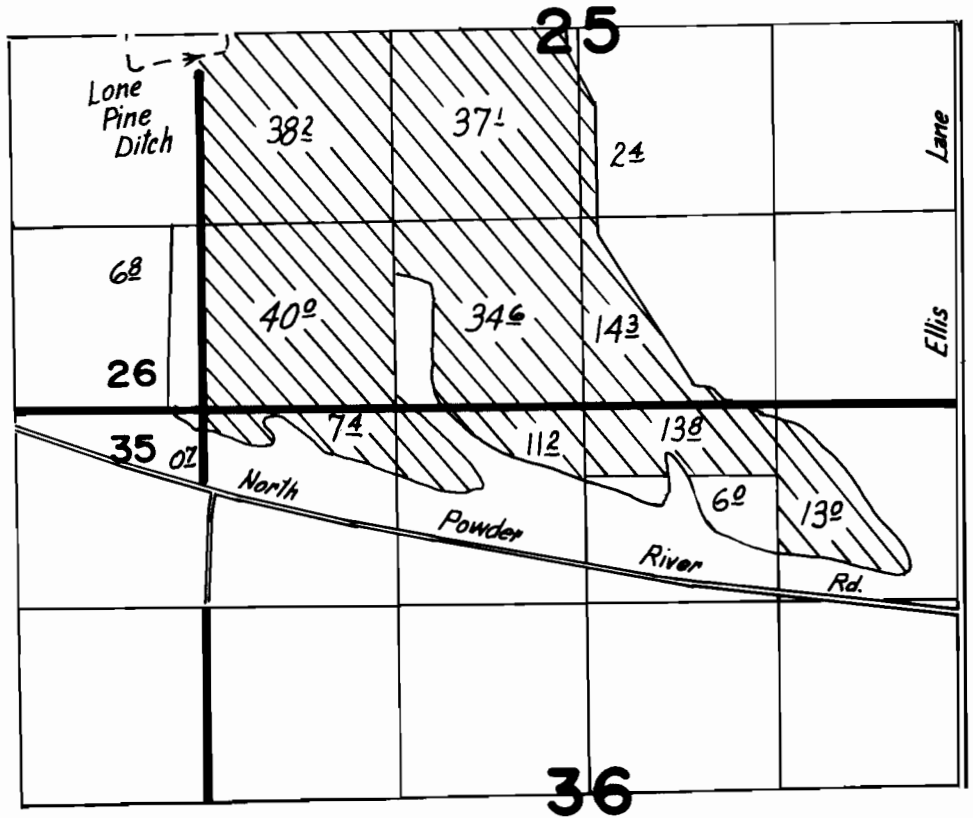

FINAL PROOF SURVEY UNDER

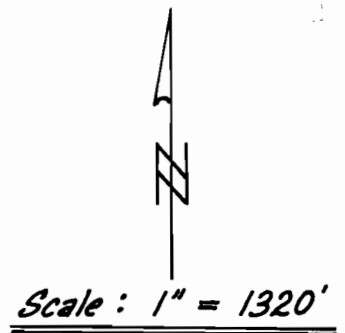

Application No. **58092** Permit No. **43779**
IN NAME OF

BILL CANTRELL

Surveyed **6-4** 19**87**, by **Vern Church**

41001-279-276R
41001-179-275R KK 1/89