


T. 35 S., R. 7 W., W.M.

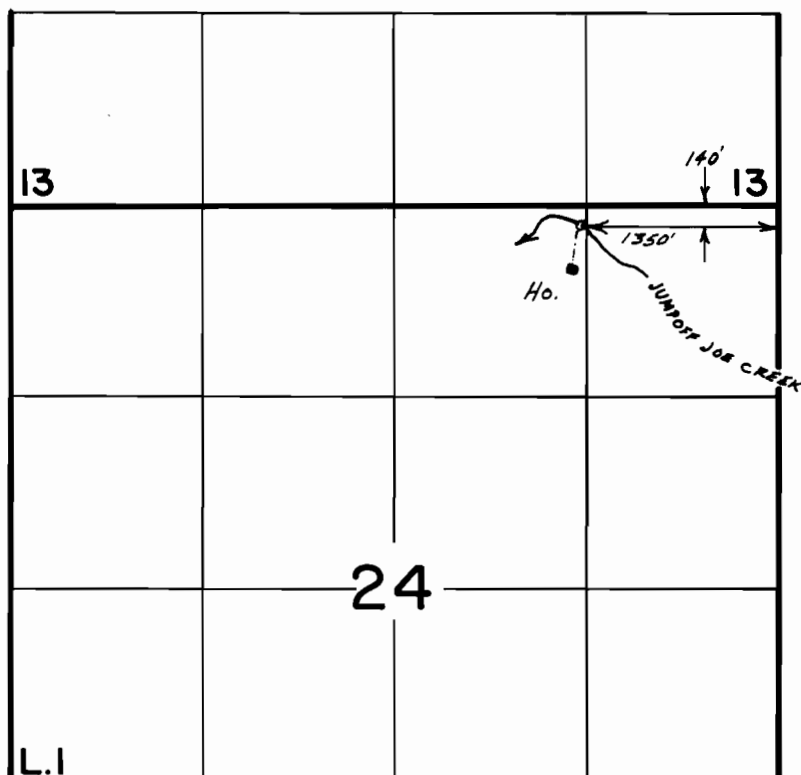

Scale 1" = 1320'



FINAL PROOF SURVEY
UNDER

Application No. 58967.. Permit No. 44574.....
IN NAME OF

.....JACK R. GIBSON.....

Surveyed Oct. 28., 1987, by B.S.JAMES.....