


P-44420

T.14 S., R.30E., W.M.

N

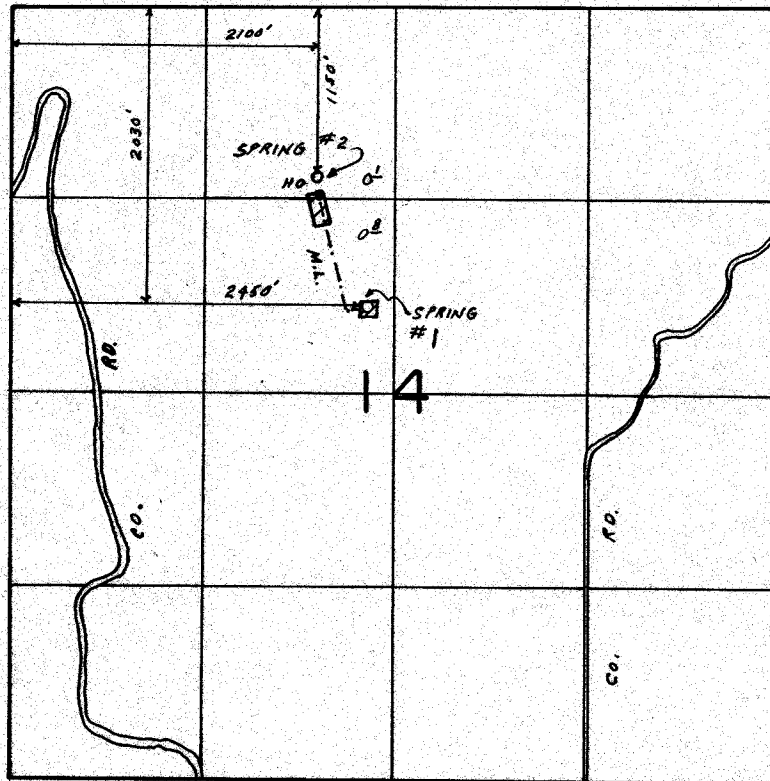

SCALE: 1"=1320'

FINAL PROOF SURVEY
UNDER

Application No. 58991... Permit No. 44420.....
IN NAME OF

WM. D. TYREE

Surveyed JUN. 19. 1988., by Z.F. SALEH.....

PHOTO. 41023-179-315L

4/11/89
L.D.C.