


T. 36 S., R. 7 W., W. M.

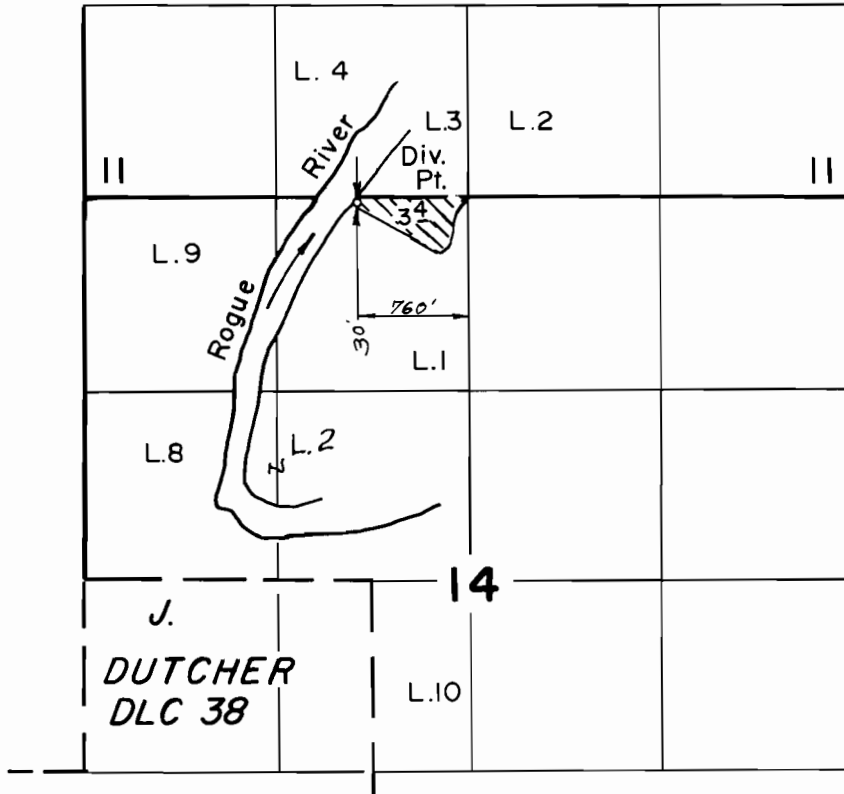

Scale: 1" = 1320'

**FINAL PROOF SURVEY**  
UNDER

Application No. 59781 Permit No. 44985

IN NAME OF

KATHLEEN REID

Surveyed OCT. 6, 1987, by B. S. JAMES