


T. 39 S., R. 11 E., W.M

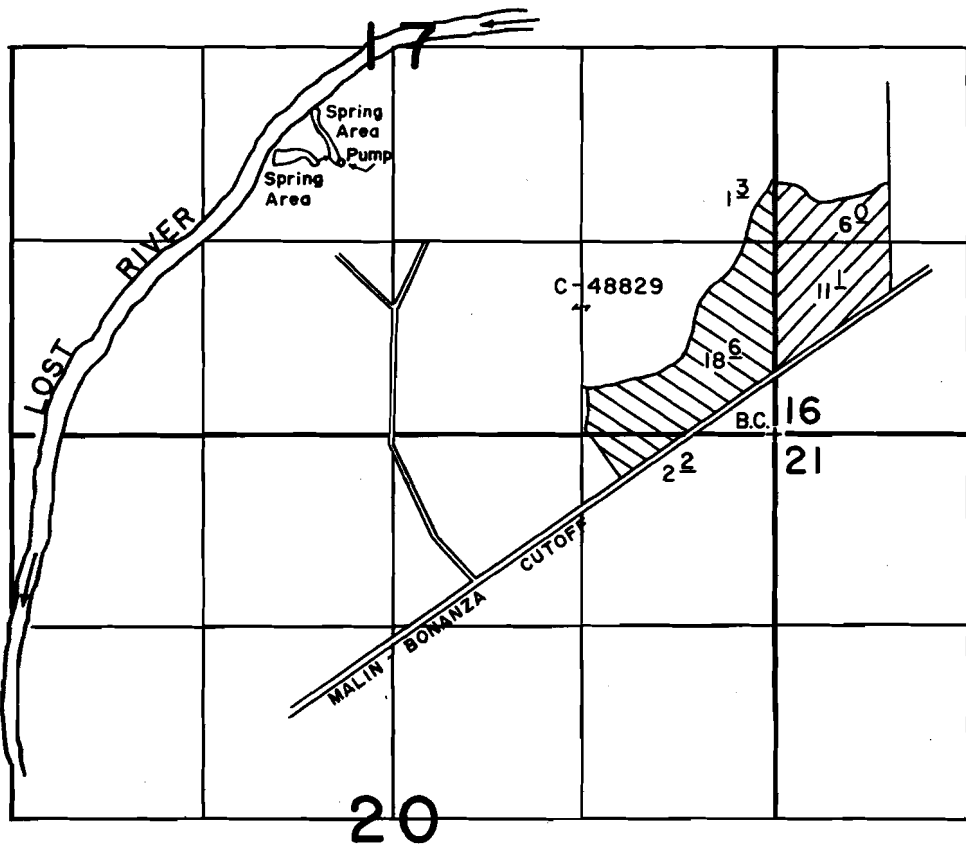

SPRING AREAS LOC.: 1900' N. & 600' W., 2000' N. & 450' W. BOTH FROM THE S.1/4 CORNER OF SECTION 17.

SCALE: 1" = 1320'

FINAL PROOF SURVEY UNDER

60086 46179 
 Application No. 64131 Permit No. 49597 
 IN NAME OF

ARIE & ELSO DEJONG

Surveyed SEPT. 13 1989, by B. W. BISHOP

1-16-90
41035-278-710

Lost River Misc.