


49597
66124

T. 39 S., R. 11 E., W.M

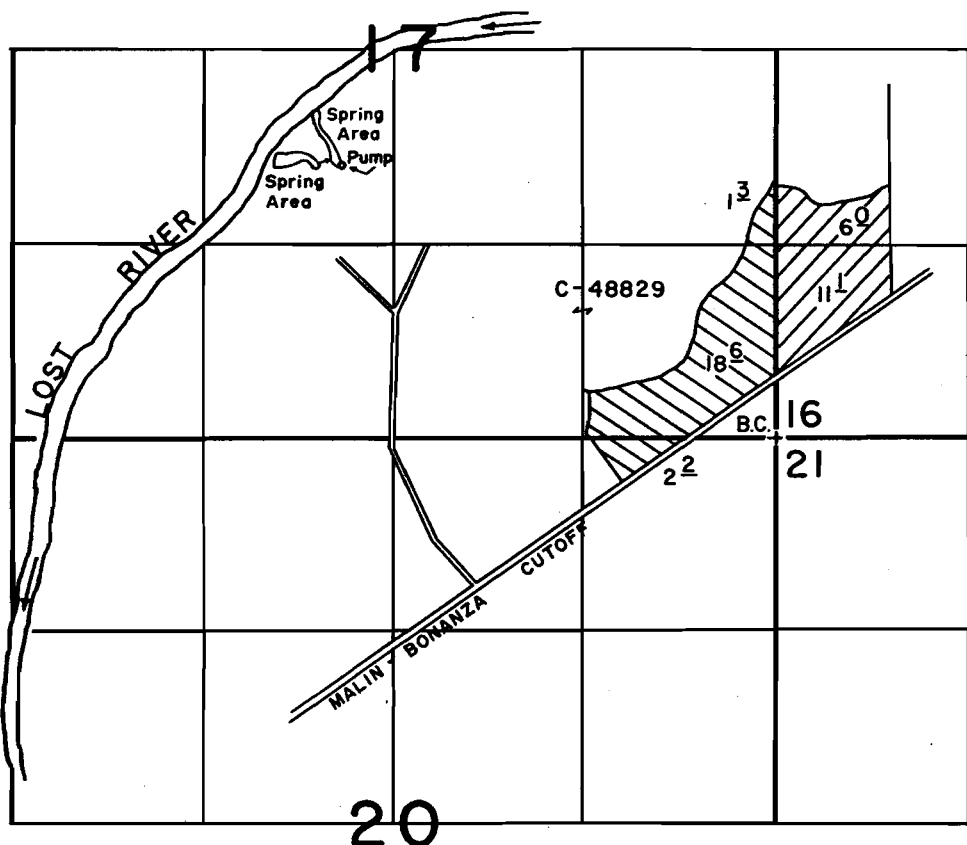

SPRING AREAS LOC.: 1900' N. & 600' W., 2000' N. & 450' W. BOTH FROM THE S.1/4 CORNER OF SECTION 17.

SCALE: 1" = 1320'

FINAL PROOF SURVEY UNDER

60086 46179 
 Application No. 64131... Permit No. 49597... 
 IN NAME OF

..... **ARIE & ELSO DE JONG**

Surveyed SEPT. 13 1989, by B. W. BISHOP.....

Lost River Mac.