


T. 27 S., R. 13 W., W. M. .

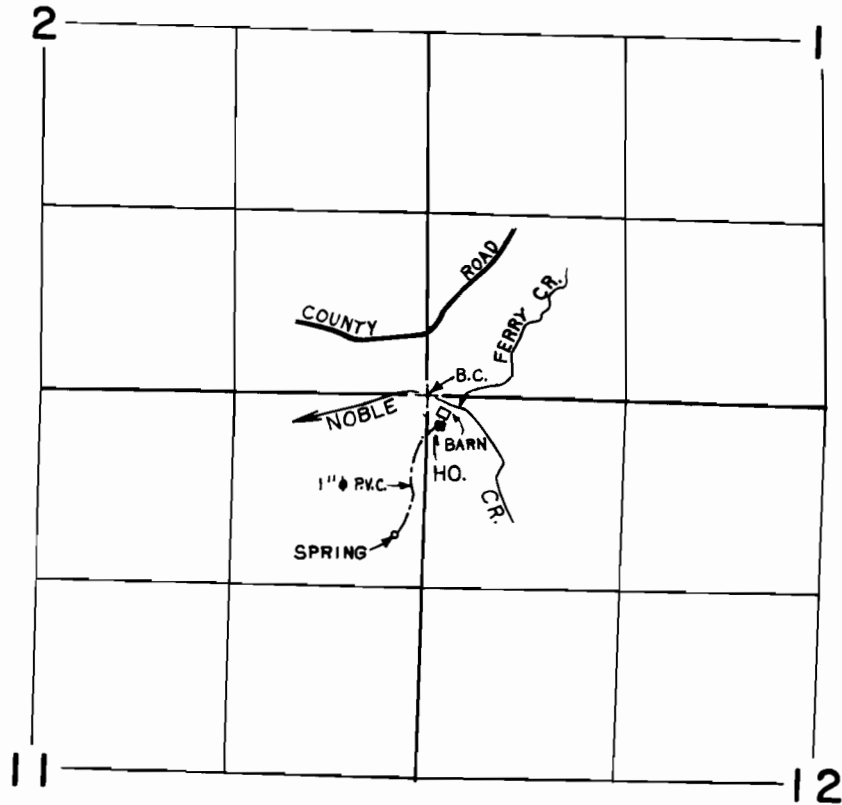

SPRING LOCATED 960'S. & 210'W. FROM N.E. COR. SEC. 11

SCALE: 4"=1 mile

FINAL PROOF SURVEY
UNDER

Application No. 60808. Permit No. 45414.....
IN NAME OF

CLYDE & DOROTHY HAGA

Surveyed OCT. 20, 1983., by L. CASHION....