


T.22S., R.5 W., W.M.



LOTS 5 & 6 AND FRACTIONAL LOTS 8, 9 & 10
 IN BLOCK 12 OF GARDNER'S ADDITION TO
 THE CITY OF DRAIN.

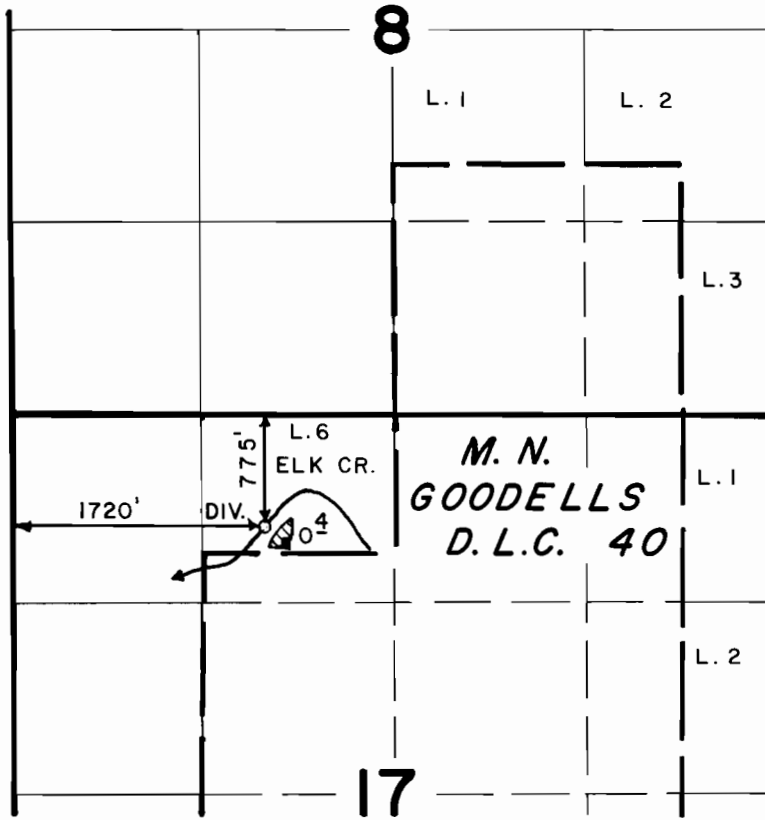

SCALE: 1" = 1320'

FINAL PROOF SURVEY UNDER

Application No. 60906. Permit No. 45326.....
 IN NAME OF

VICTOR A. & SHELLY R. NOBERT

Surveyed OCT. 20. 1986, by J. M. SCHMORDE