


# T. 30S., R. 5W., W. M. SECTIONS 6 AND 7

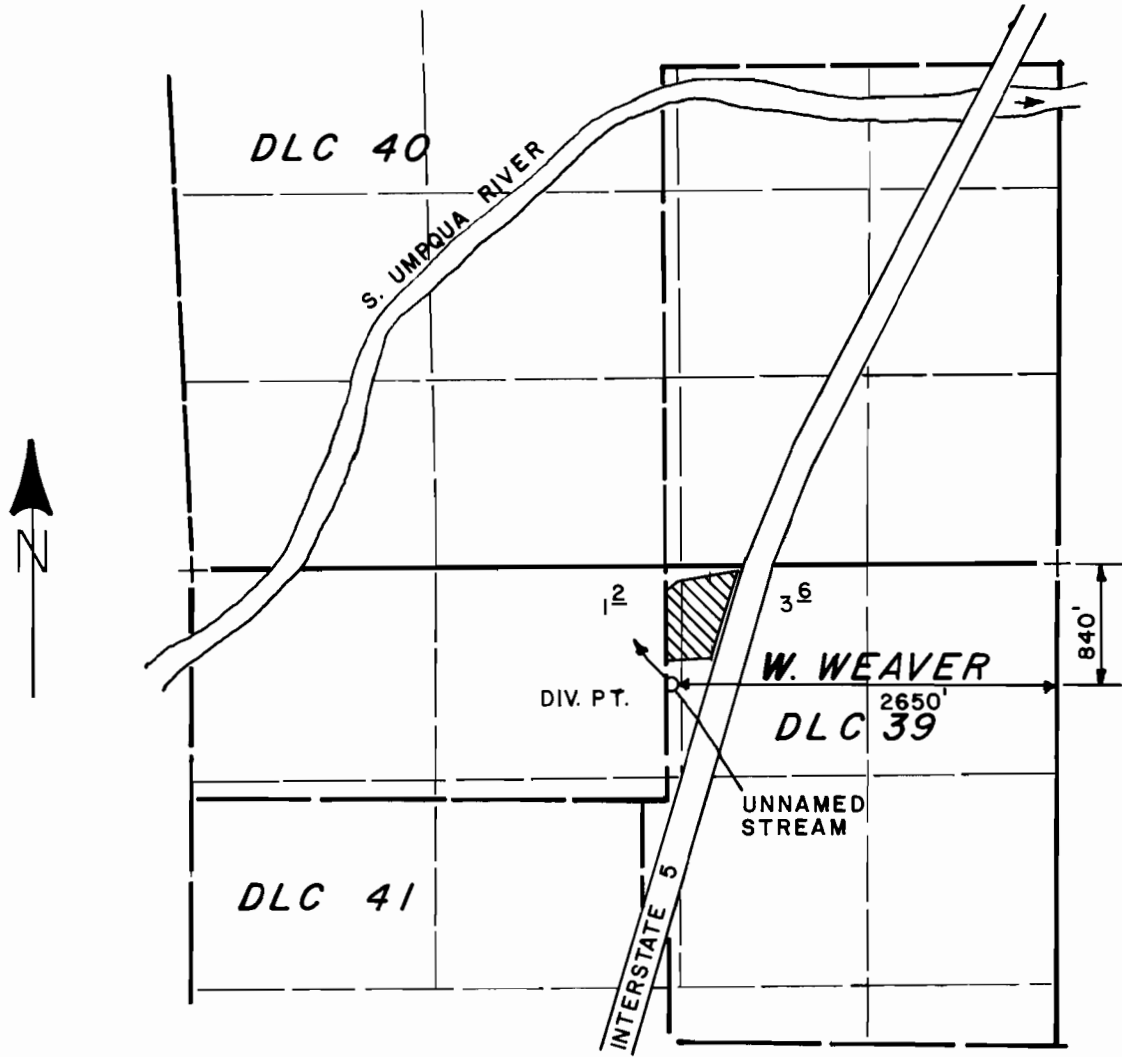

SCALE: 4" = 1 MILE

## FINAL PROOF SURVEY UNDER

Application No. 61006... Permit No. 45485.....

IN NAME OF

**HERBERT S. WATSON & ROBERTA WATSON**

Surveyed JUNE 19 1984, by L. E. CASHION.....