


T. 29 S., R. 4 W., W.M. SECTION 4

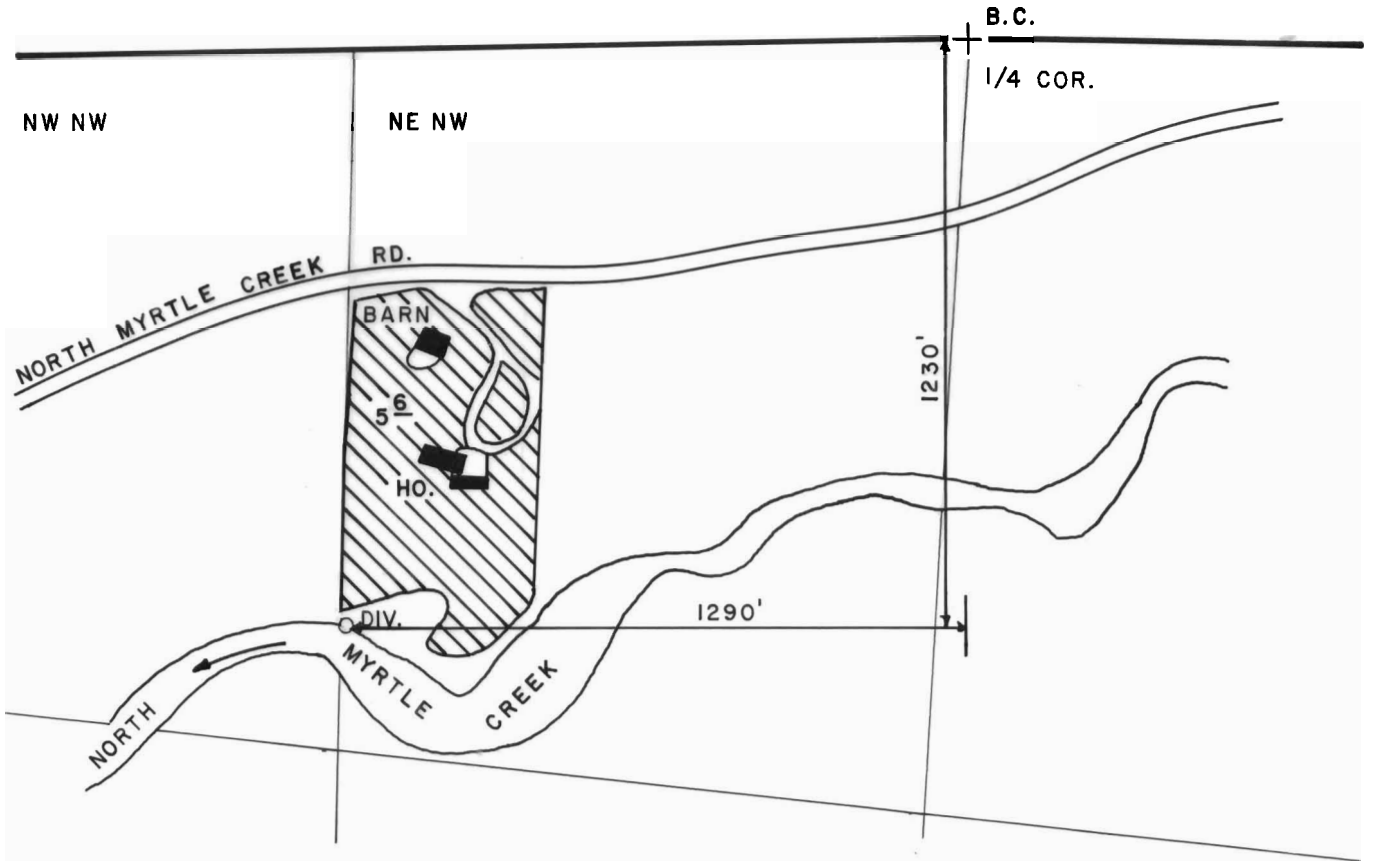

SCALE: 1" = 400'

FINAL PROOF SURVEY UNDER



Application No. 61088... Permit No. 45493.....
IN NAME OF

CHARLES F. LASS

Surveyed MAY 15... 1986, by J. M. SCHMORDE