


T. 32 S., R. 6 W., W.M.

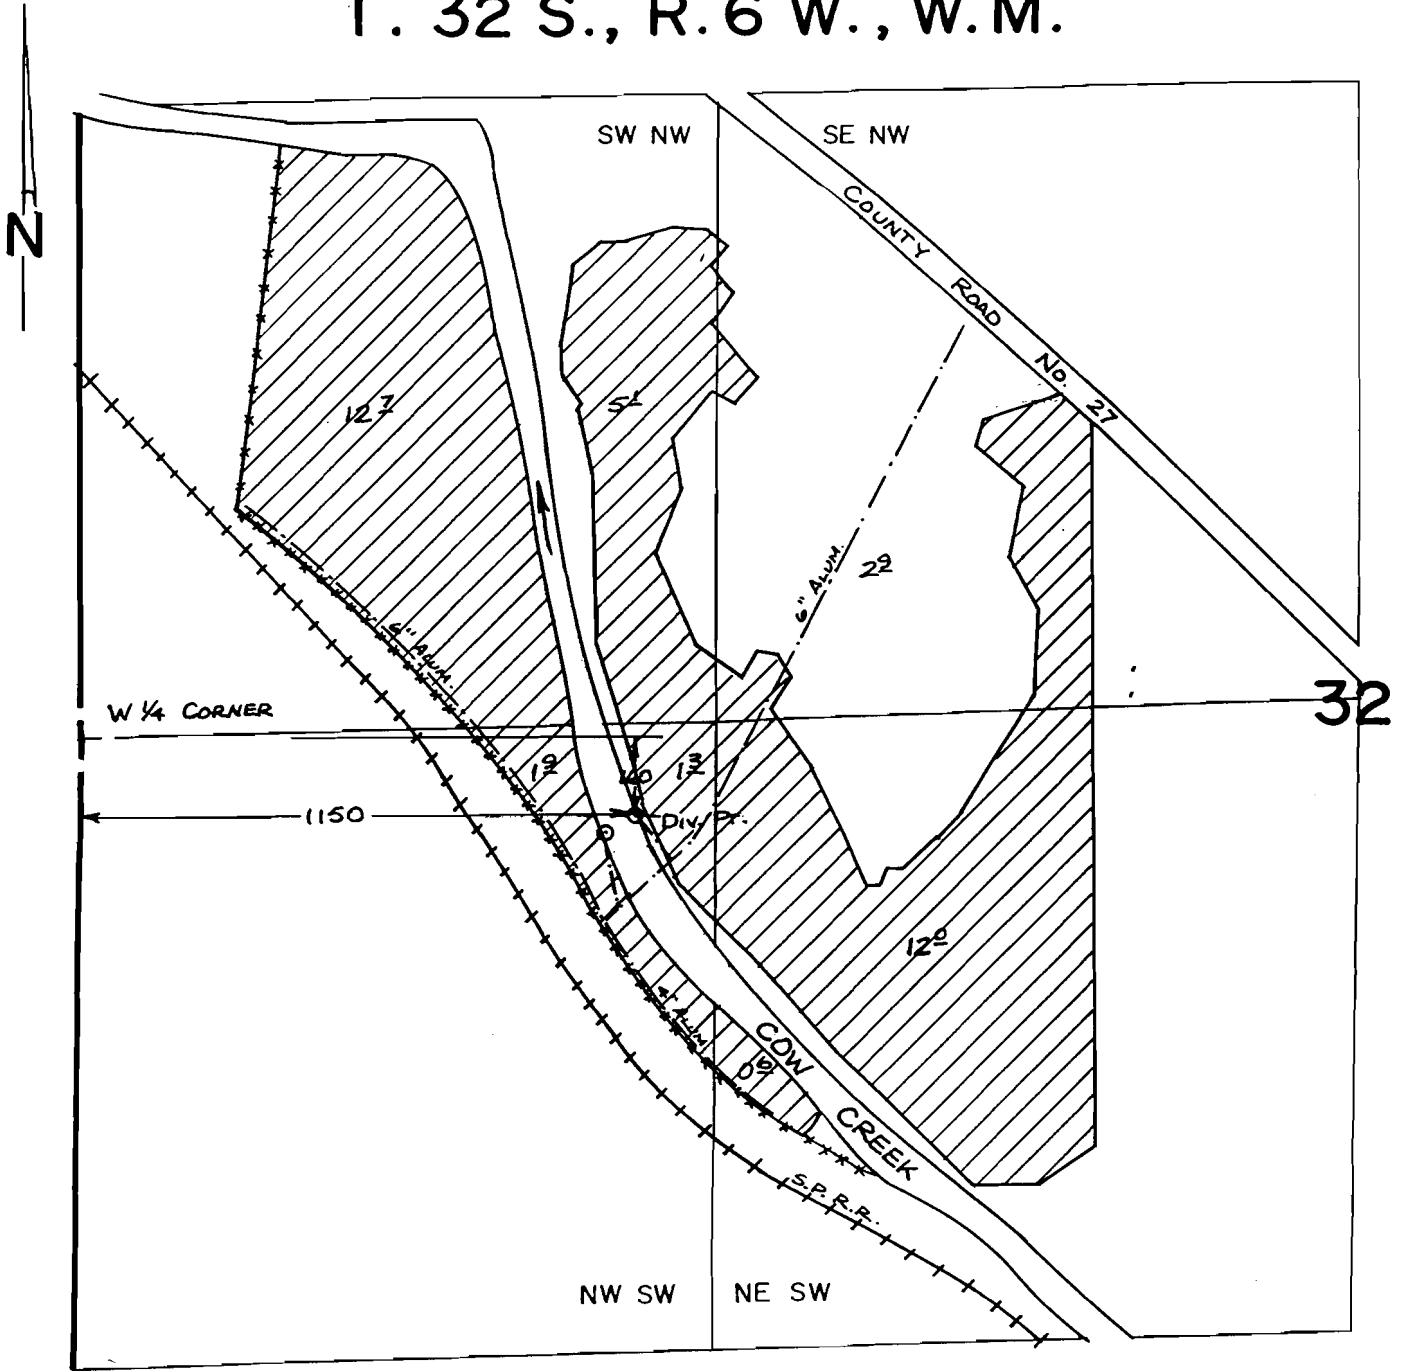

FINAL PROOF SURVEY
UNDER

SCALE: 1" = 400'

Application No. ...61112... Permit No.45494....
IN NAME OF

E. J. WORMAN

8/15 84 L. E. CASHION
Surveyed ...2.7.17.... 19.89., by ...M. SCHMORDE....