


T. 5 S., R. 4 W., W.M.

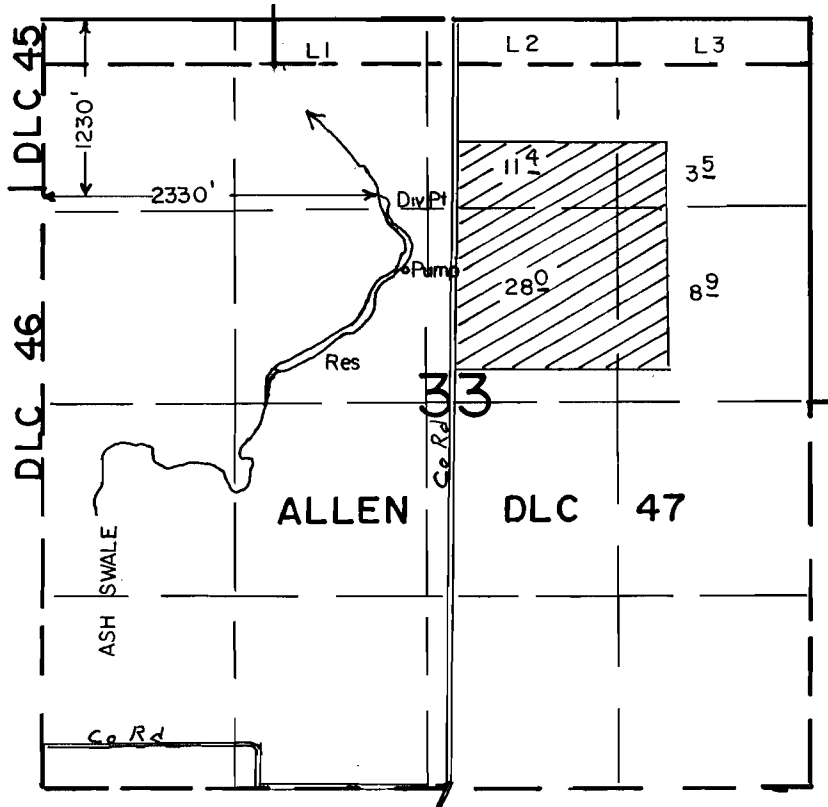

SCALE: 1" = 1320'

**FINAL PROOF SURVEY
UNDER**

Application No. 61708... Permit No. 45790.....
IN NAME OF

.....LAVERN B. GAROLD...LEPPIN.....

Surveyed OCT. 12. 1987., by B.W. BISHOP.....