


T. 38 & 39 S., R. 3 W., W. M.

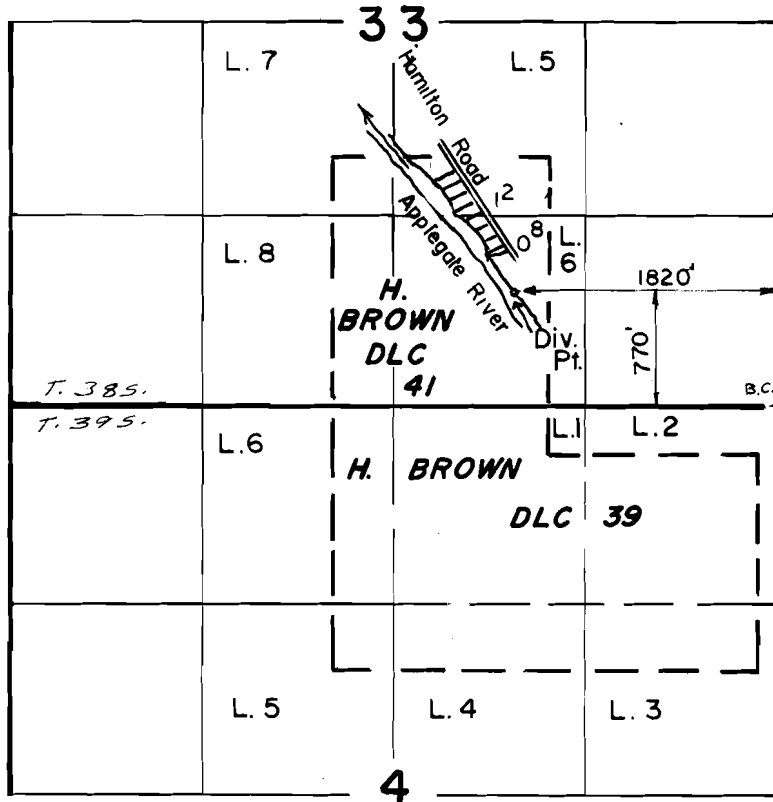

FINAL PROOF SURVEY
UNDER

Application No. **62406** Permit No. **46546**...
IN NAME OF

ROBERT H. & BETTY HYDE

Surveyed JAN. 14, 1988, by B. S. JAMES...