


T. 40 S., R. 7 W., W. M.

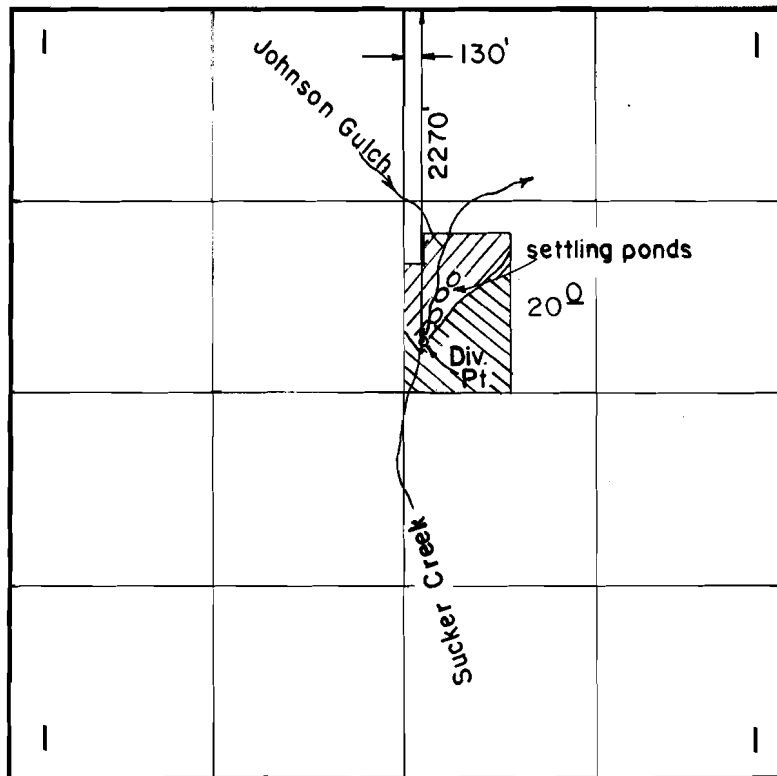

Scale: 1" = 1320'

mined 

to be mined 

FINAL PROOF SURVEY UNDER

Application No. 62760. Permit No. 46144.....
IN NAME OF

.....FRED BEAN.....

Surveyed APR. 14. 1988, by B. S. JAMES.....