


T.5 & 6 S., R.4 W., W. M.

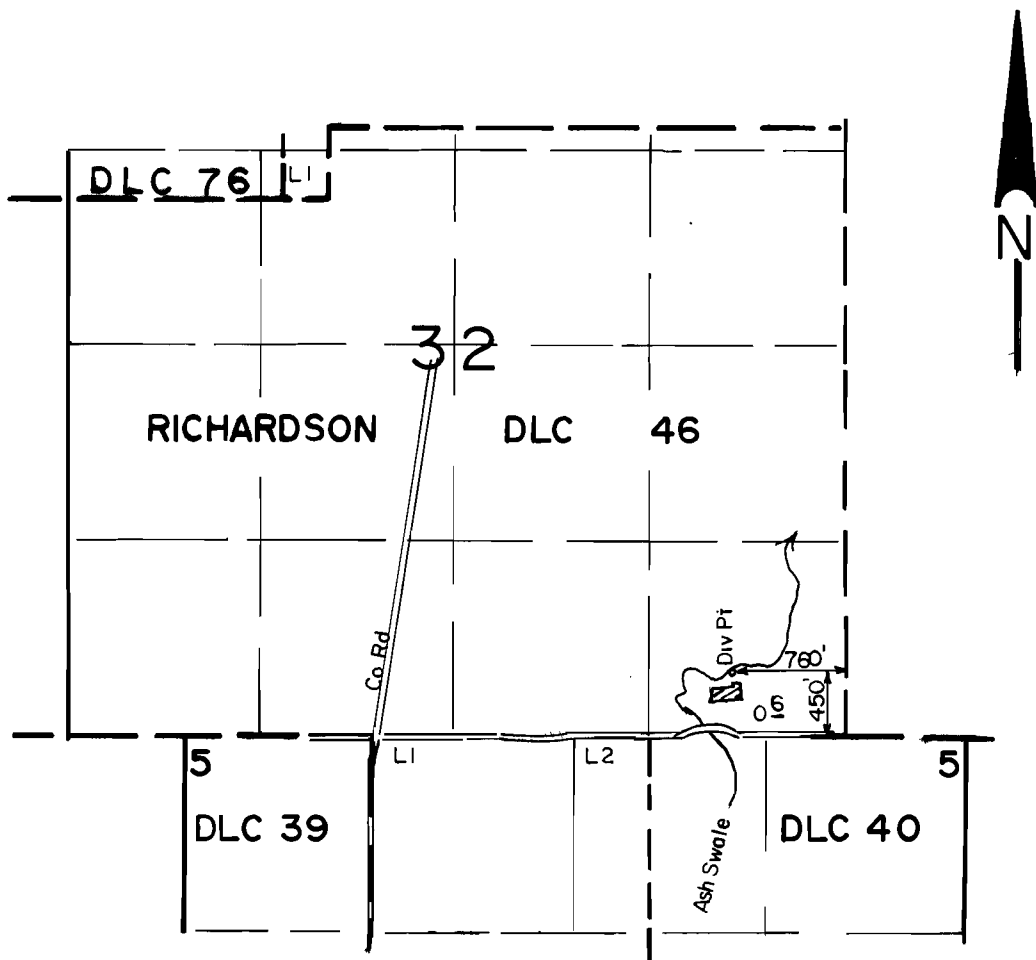

SCALE: 1"=1320'

FINAL PROOF SURVEY
UNDER

Application No. 63005.. Permit No. 46635.....
IN NAME OF

.....KENNETH R. GOUGH.....

Surveyed JULY 9... 1987., by B.W. BISHOP.....