90684

T. 4 S., R. 4 W., W. M.

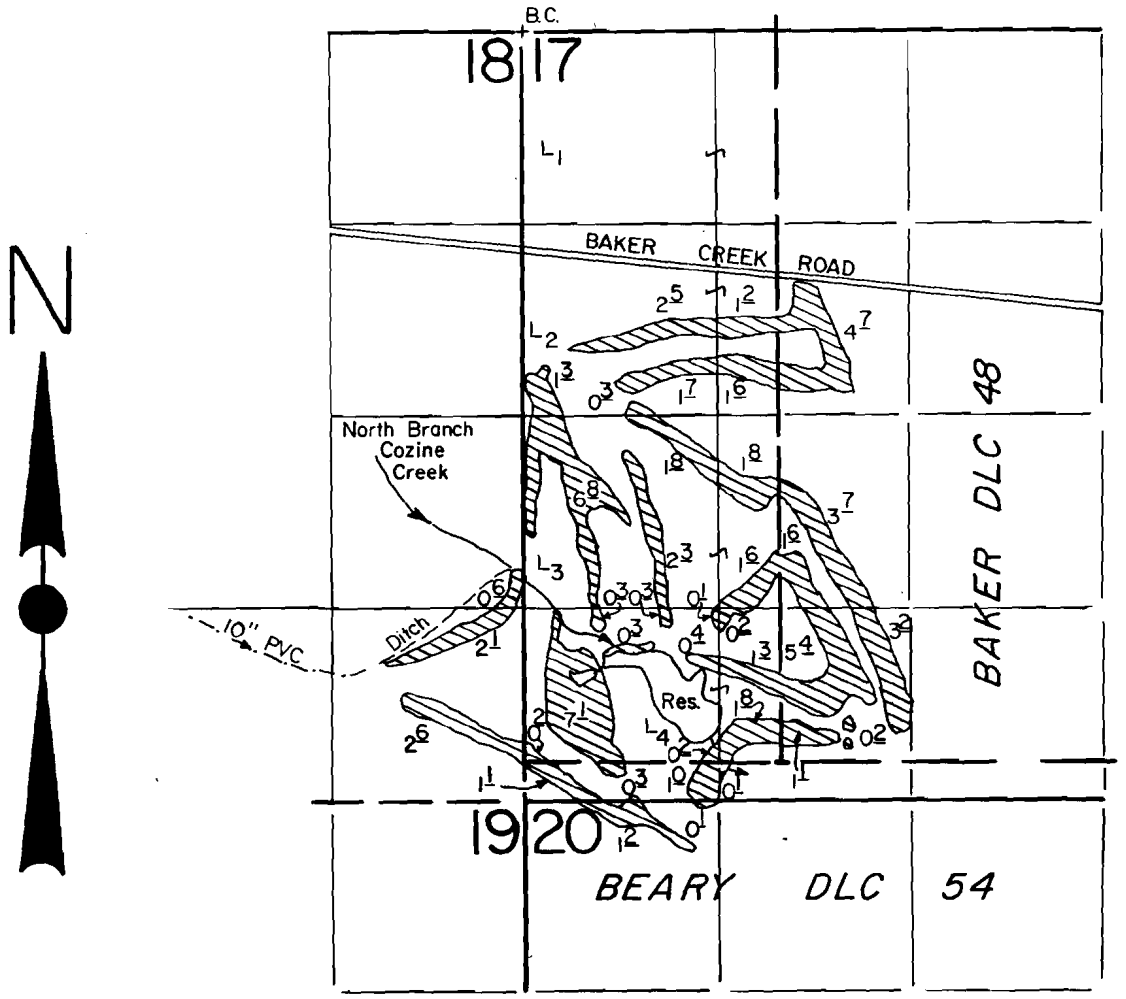

P.O.D. Loc.: 420' N. & 1270' E. from SW Cor. Sec. 17.

Section 18
S 1/2 SW 1/4

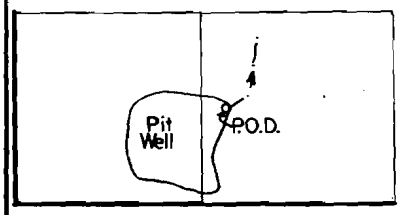

Well Loc.: 670' N. & 1460' E. from SW Cor. Sec. 18.

Scale : 1" = 1320'

FINAL PROOF SURVEY
UNDER

G-11038 G-10202
R-63048 R-8344
Application No. 63049 Permit No. 46419
IN NAME OF

MICHELBOOK ESTATES, INC.

Surveyed Nov. 21 1989, by T. Warren

W.A.C. COLOR PHOTO + DFQ-1LL-102
TMW 1/..100