



# T. 4 S., R. 4 W., W. M.

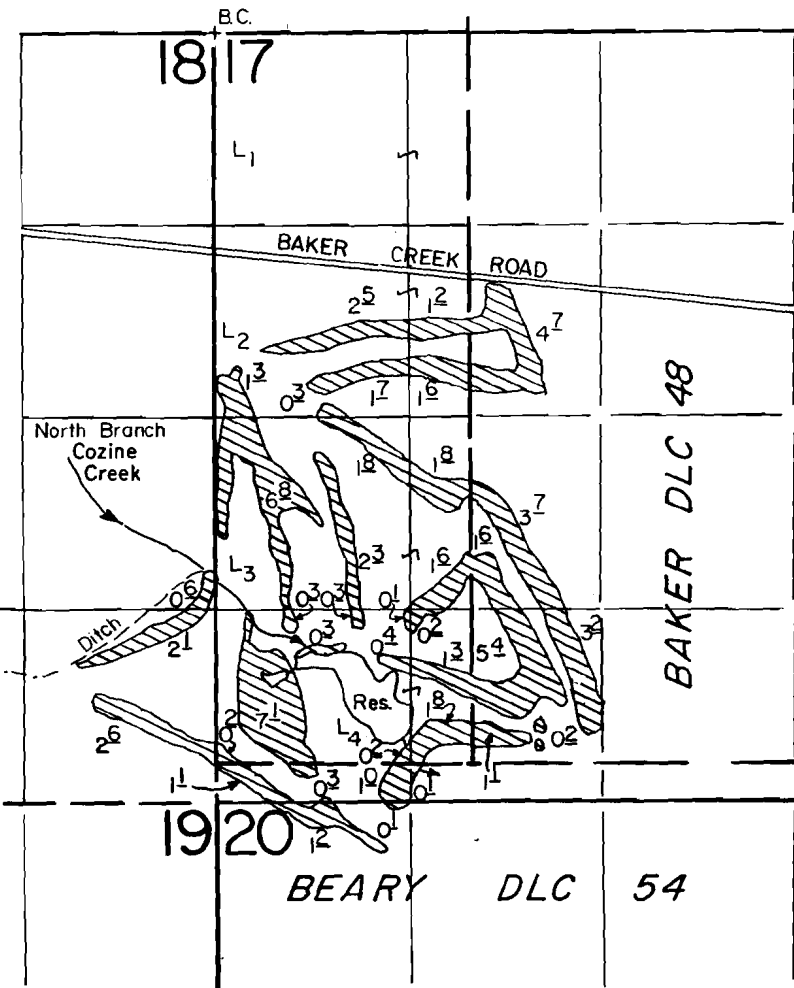

P.O.D. Loc.: 420' N. & 1270' E. from SW Cor. Sec. 17.

Section 18  
S 1/2 SW 1/4

Scale : 1" = 1320'

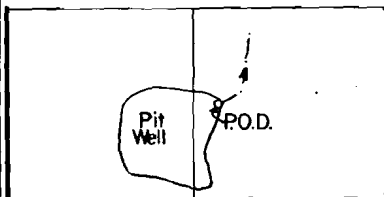

## FINAL PROOF SURVEY UNDER

Well Loc.: 670' N. & 1460' E.  
from SW Cor. Sec. 18.

G-11038                      G-10202  
 R-63048                      R-8344  
 Application No. 63049 Permit No. 46419  
 IN NAME OF

**MICHELBOOK ESTATES, INC.**

Surveyed Nov. 21, 1989, by T. Warren