


T.16S., R.5W., W. M.

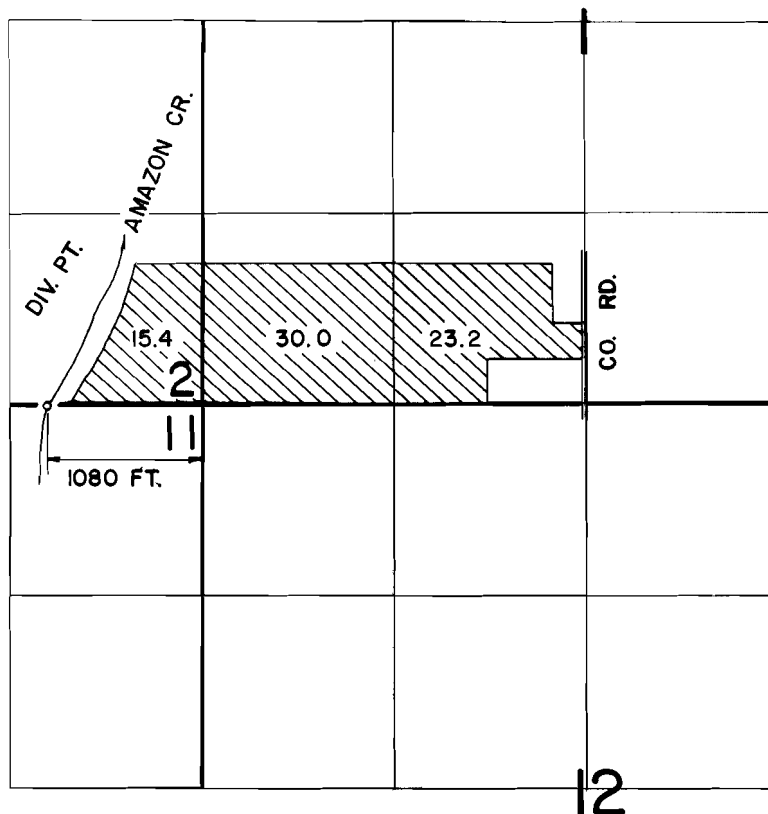


FINAL PROOF SURVEY
UNDER

Application No. 63629.. Permit No. 46995.....
IN NAME OF

.....LARRY M. AMSBERRY.....

Surveyed MAY 8, 1984, by *P. Porter*.....

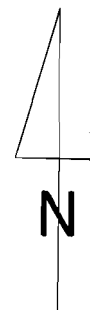

SCALE: 4" = 1 MILE