


T40S., R.14 W., W. M.

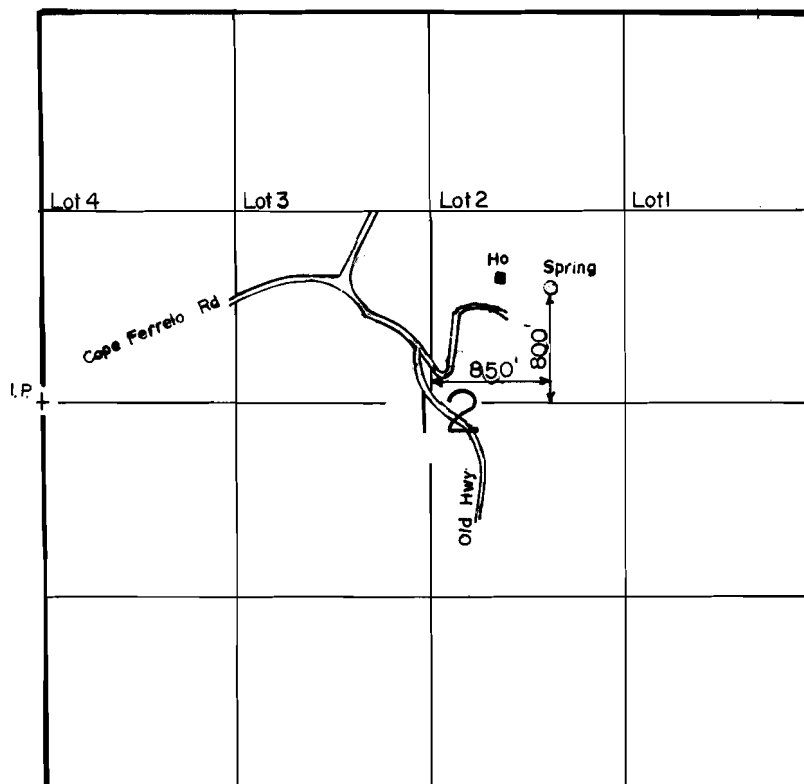

SCALE: 1"=1320'

**FINAL PROOF SURVEY
UNDER**

Application No. 63716... Permit No. 47278.....
IN NAME OF

.....DANIEL C BERRY.....

Surveyed JUNE 6... 1990., by B.S. JAMES.....