


T.29S., R.8 & 9 W., W.M.

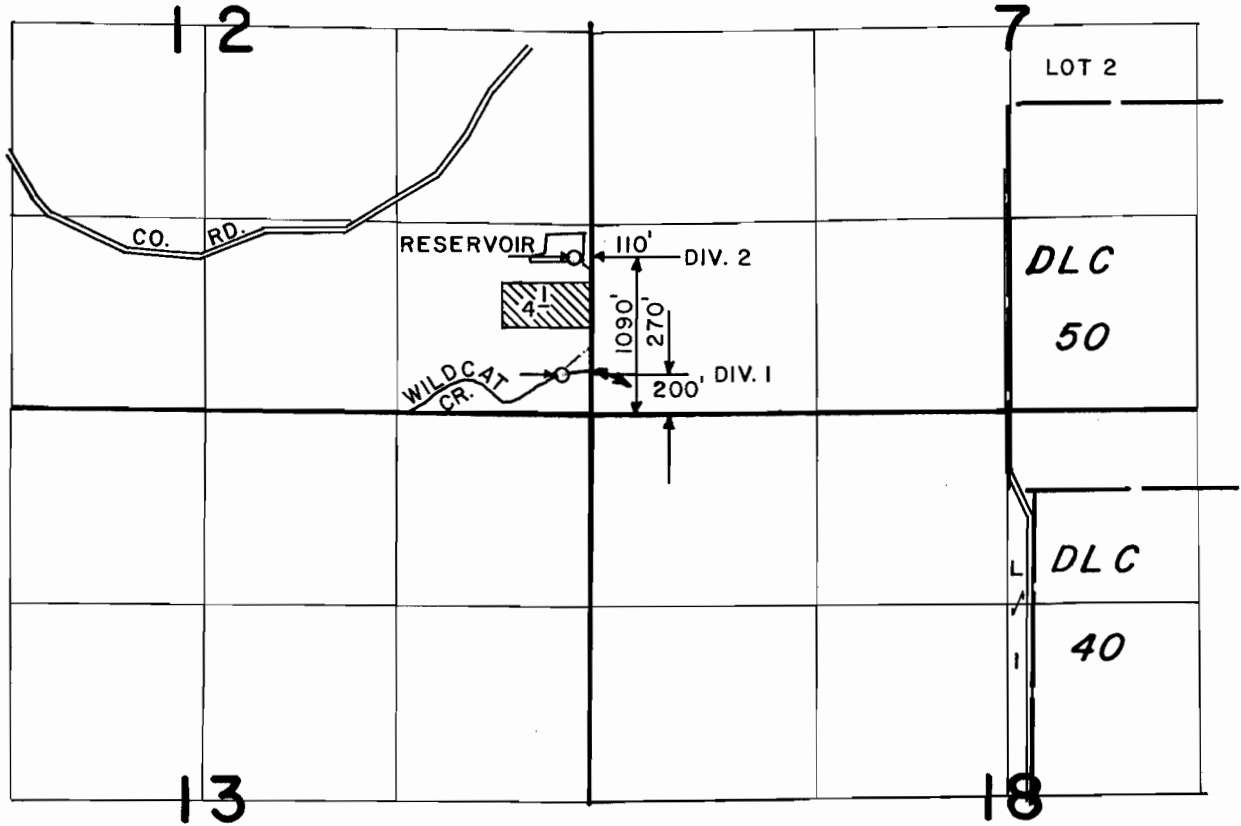

SCALE: 4" = 1 MILE

**FINAL PROOF SURVEY**  
UNDER



R-63964                      R-8520  
Application No. 63965    Permit No. 47097  
IN NAME OF

**ROBERT L. THRUSH**

Surveyed JUNE 22, 1988, by J. M. SCHMORDE