


T. 29 S., R. 8 & 9 W., W. M.

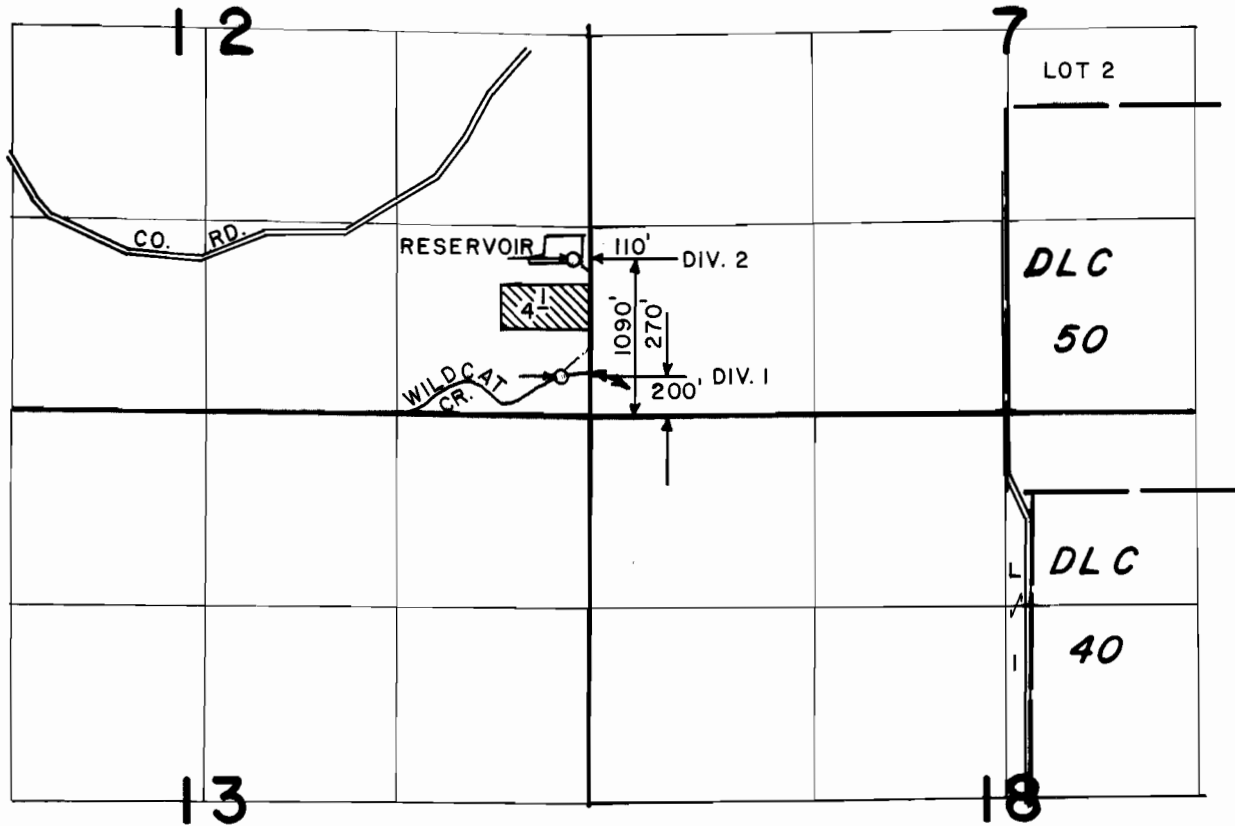

SCALE: 4" = 1 MILE

FINAL PROOF SURVEY
UNDER



R-63964 R-8520
Application No. 63965 Permit No. 47097
IN NAME OF

ROBERT L. THRUSH

Surveyed JUNE 22, 1988, by J. M. SCHMORDE