


T. 40 S., R. 14 W., W.M.

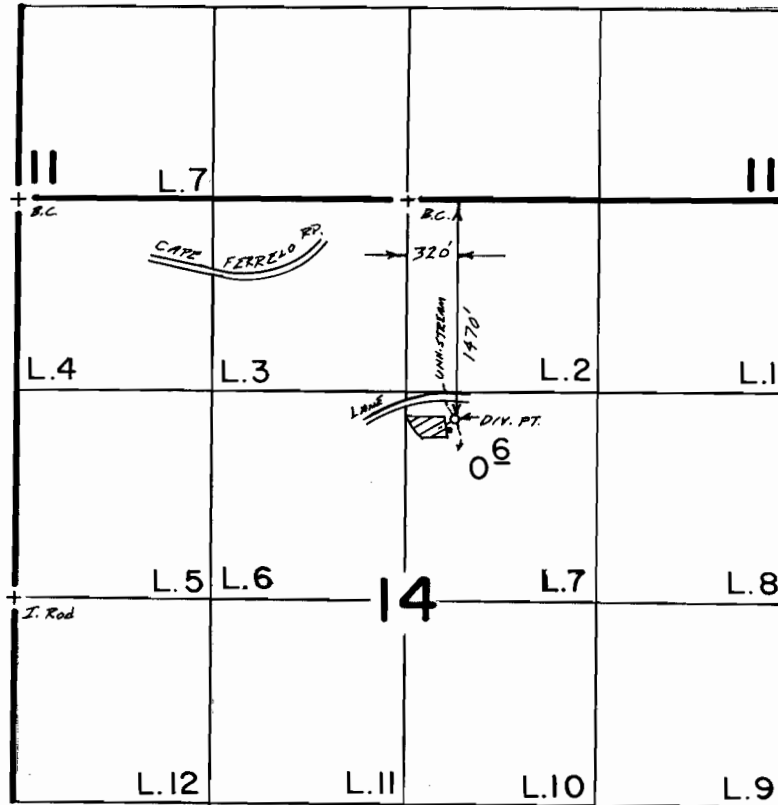

Scale 1" = 1320'

FINAL PROOF SURVEY UNDER

Application No. 64327 Permit No. 47316
IN NAME OF

PHILLIP D. CAPOUCH

Surveyed Sept. 30, 1987, by B.S. JAMES