




T.17 S., R. 5 W., W.M.

SECTION 20


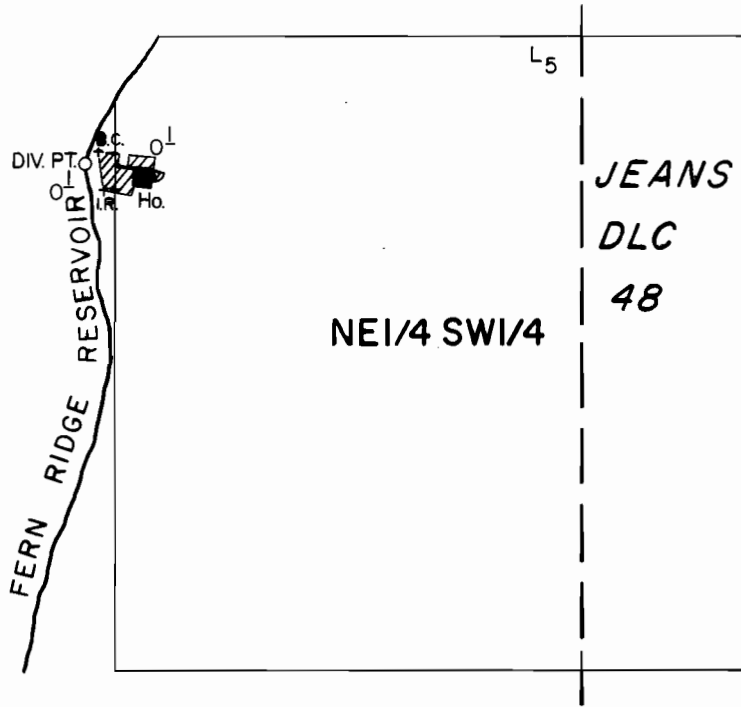

DIV. PT. LOC: 260'S. & 1380'W. FROM C.1/4 CORNER SEC. 20

SCALE: 1" = 400'

**FINAL PROOF SURVEY**  
UNDER

Application No. 64797... Permit No. 47526  
IN NAME OF

..... LEO & MARY BEACH .....

Surveyed OCT. 15... 1986, by T. WARREN.....