


T. 36 S., R. 4 W., W. M.

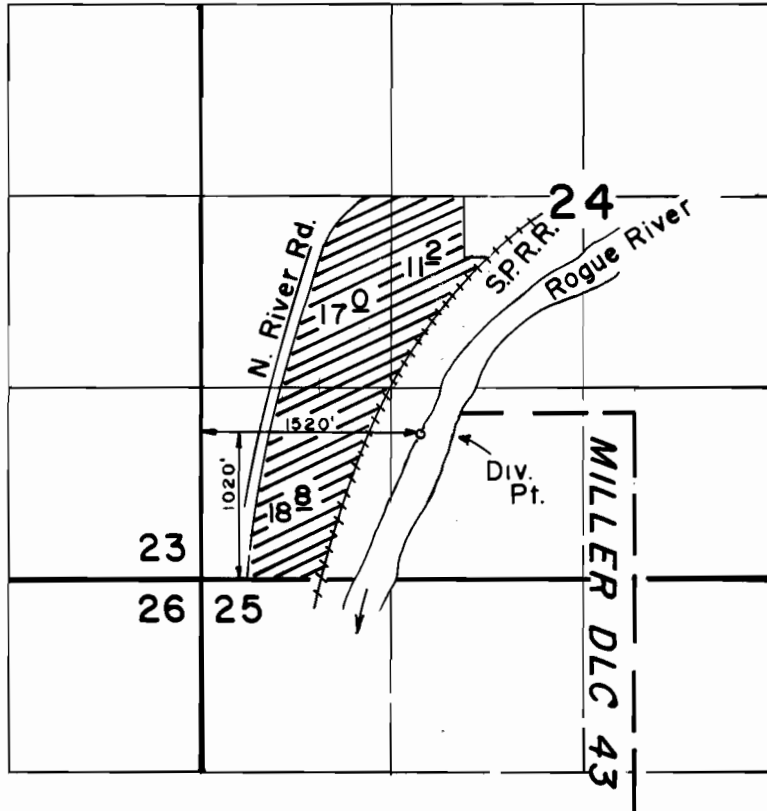

Scale: 1" = 1320'

FINAL PROOF SURVEY
UNDER

Application No. 64896 Permit No. 47491...
IN NAME OF

.....CHARLES.....R.....MAURER.....

Surveyed JUL.....3.. 1986, by B.S.....JAMES.S.