


P-47915  
C-66198

T.13S., R.29E., W.M.

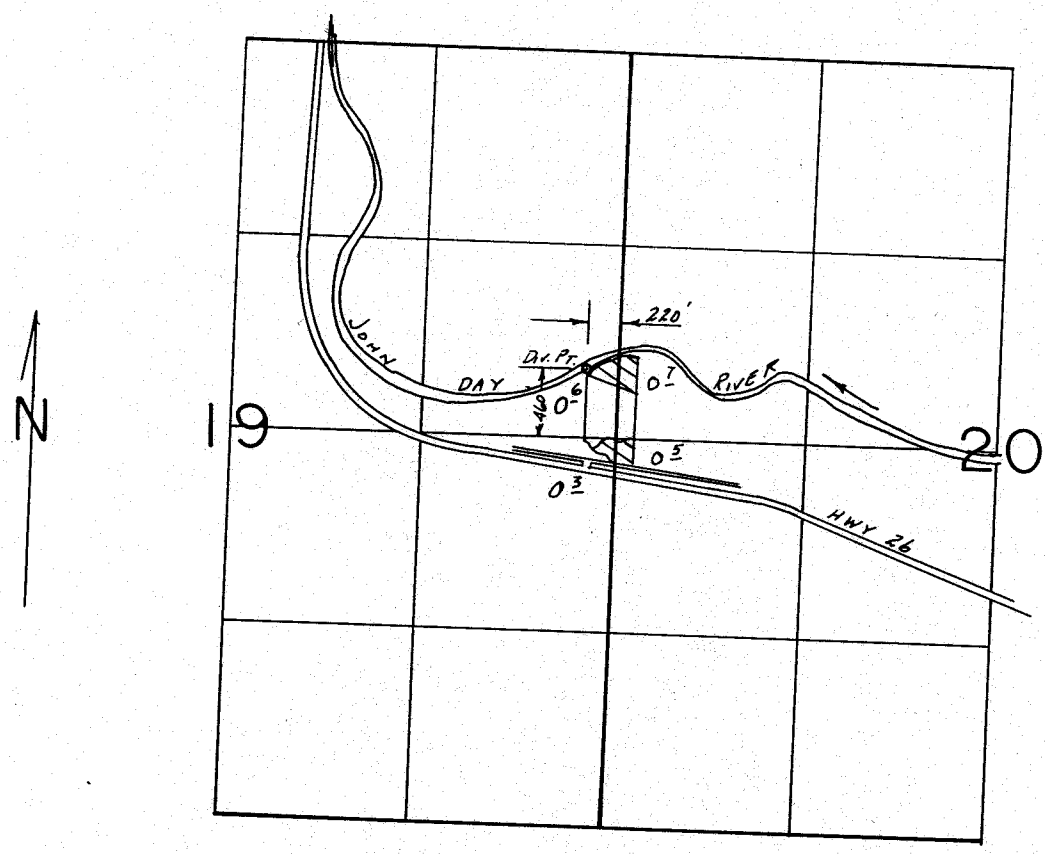

SCALE: 1" = 1320'

**FINAL PROOF SURVEY**  
UNDER

Application No. 65291... Permit No. 47915.....  
IN NAME OF

.....ELMER & JOANN JOHNSON.....

Surveyed July 7..... 1987, by V.L. CHURCH.....

4/12/89 RLB