


T. 35 S., R. 7 W., W. M.

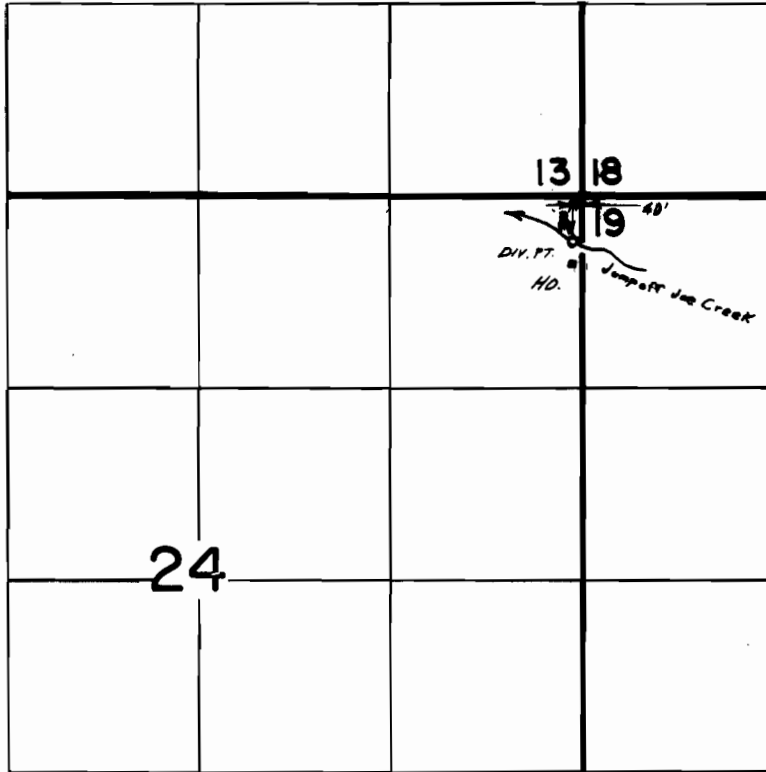

Scale 1" = 1320'

**FINAL PROOF SURVEY**  
UNDER

Application No. 66026. Permit No. 48050.....  
IN NAME OF

.....**MARY L. SOARES**.....

Surveyed Nov. 4, 1987, by B. S. JAMES.....