


T. 27S., R. 5W., W.M.
SECTION 23

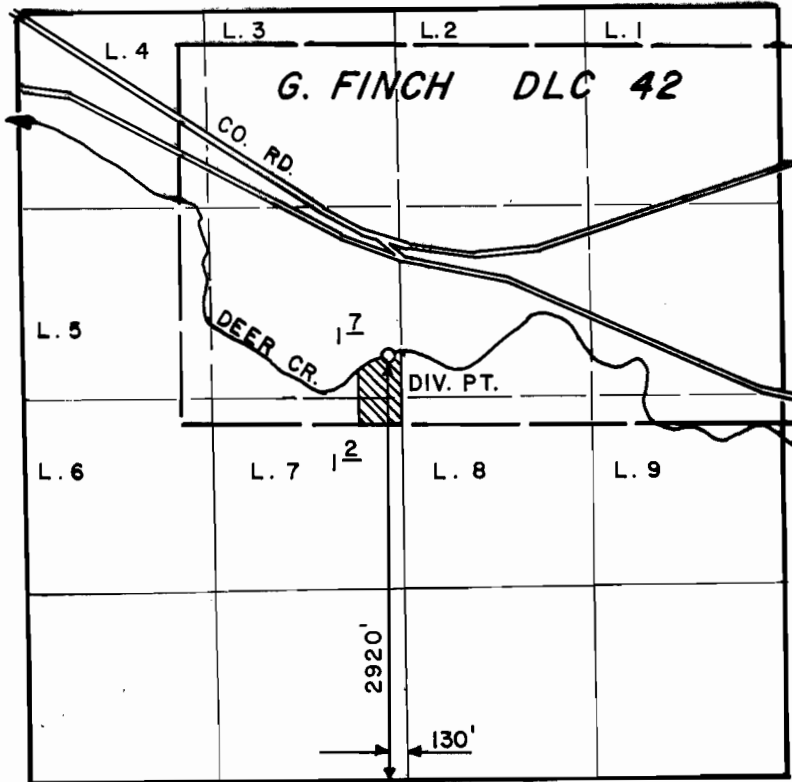

SCALE: 4" = 1 MILE

FINAL PROOF SURVEY
UNDER

Application No. 66722.. Permit No. 48120.....
IN NAME OF

RAYMOND R. GOODE

Surveyed SEPT. 23, 1987., by J.M. SCHMORDE.