


# T. 29S., R. 4 & 5W., W.M.

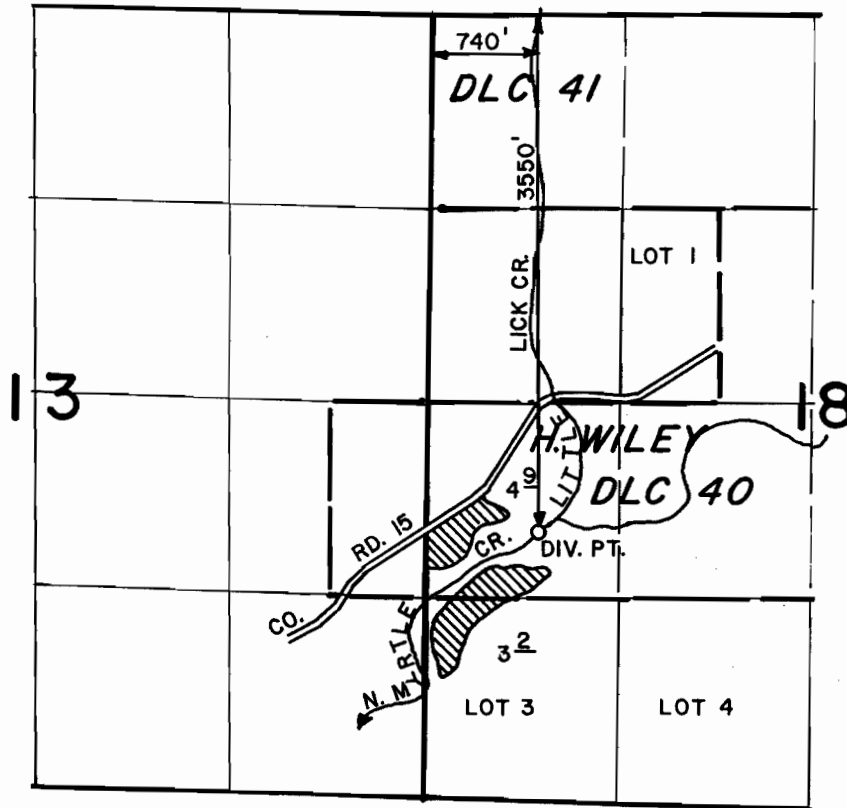

SCALE: 4" = 1 MILE

## FINAL PROOF SURVEY UNDER

Application No. 67327 Permit No. 48186  
IN NAME OF

ORVAL H. WEAVER

Surveyed JUNE 25, 1986, by J.M. SCHMORDE.