


DIAGRAM "A"

(SW 1/4)
(SW 1/4)

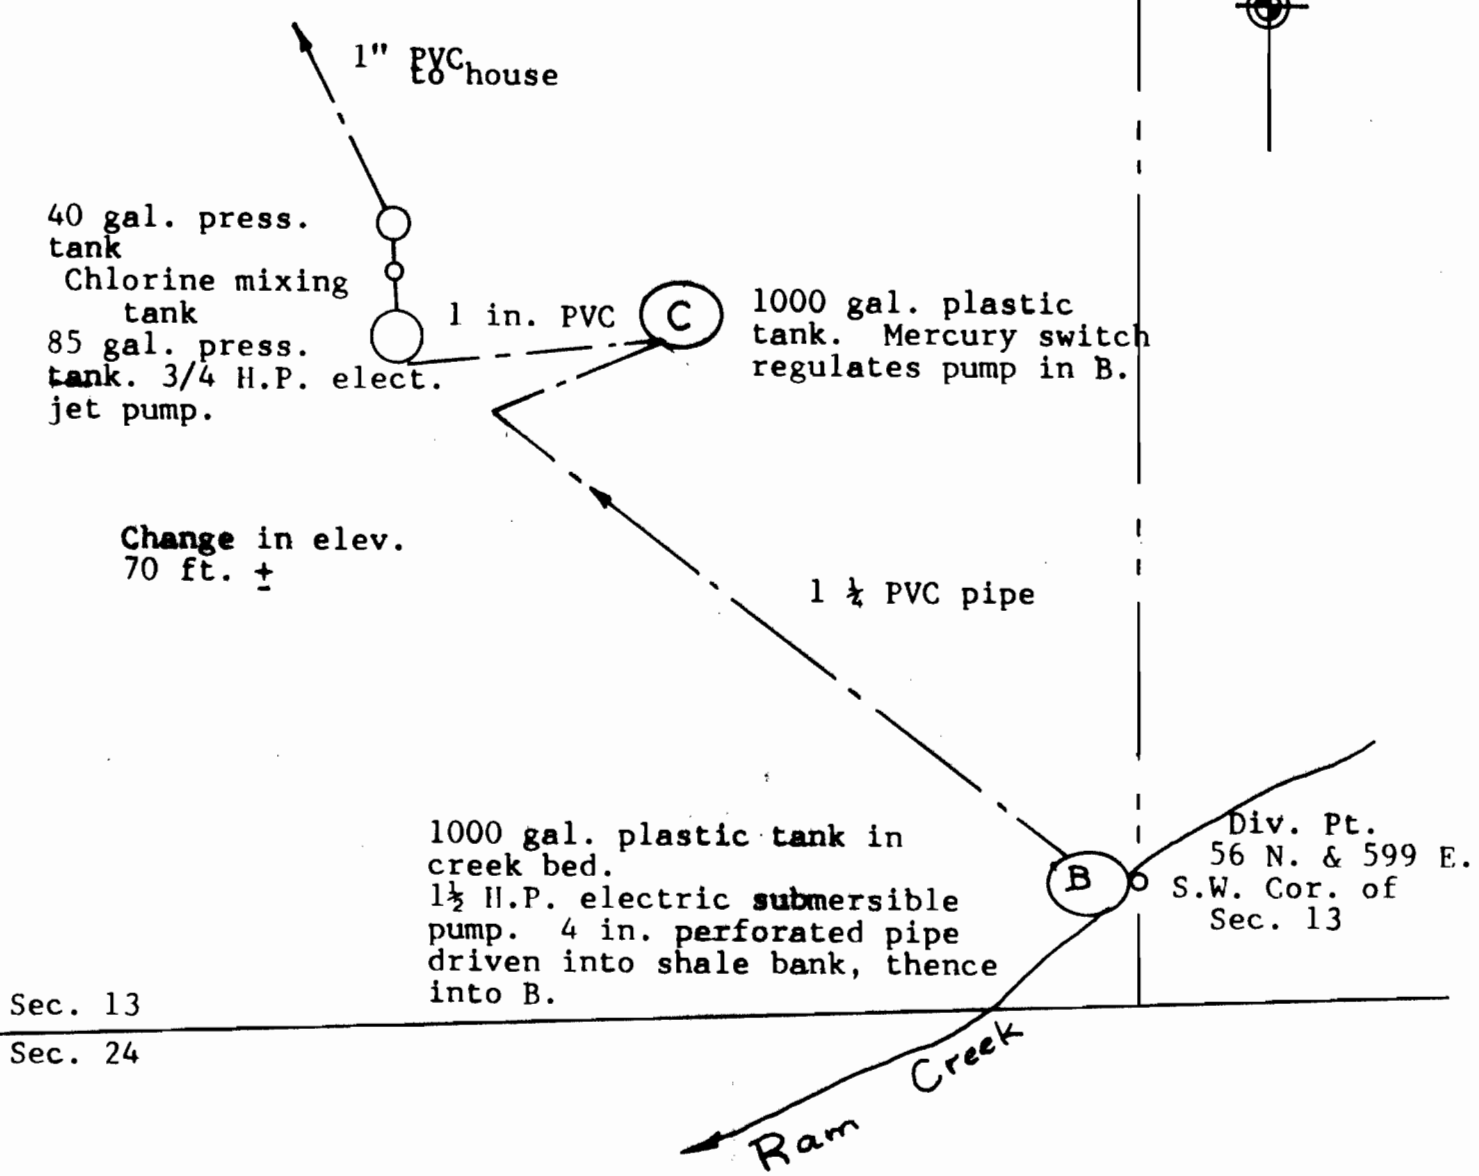

Sec. 13
Sec. 24

FINAL PROOF SURVEY
for Don & Barbara Chambers
Sec. 13, T.40S., R.14W., W.M.
Curry Co., Ore.
Jan. 1990 No Scale

