


T.29S., R.5W., W.M.

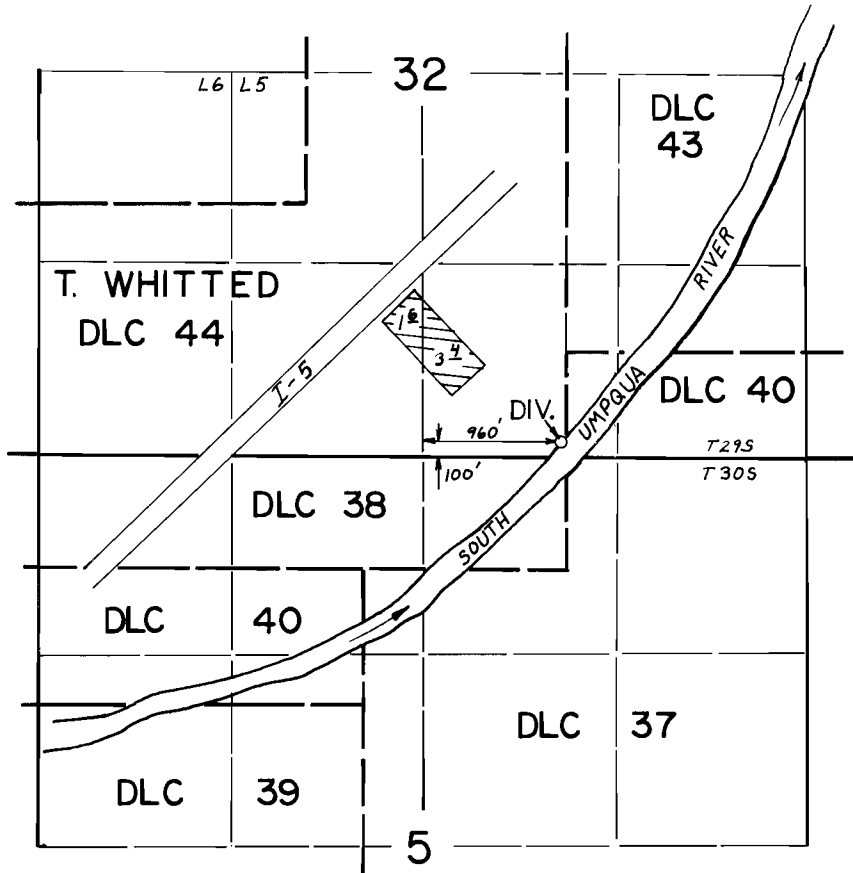

SCALE: 4" = 1 mile

FINAL PROOF SURVEY
UNDER

Application No. 68033. Permit No. 48679.....
IN NAME OF

.....MANSHACK.....

Surveyed DEC. 13, 1984, by J.E. Cashion.....