


T. 30 S., R. 2 W., W.M.

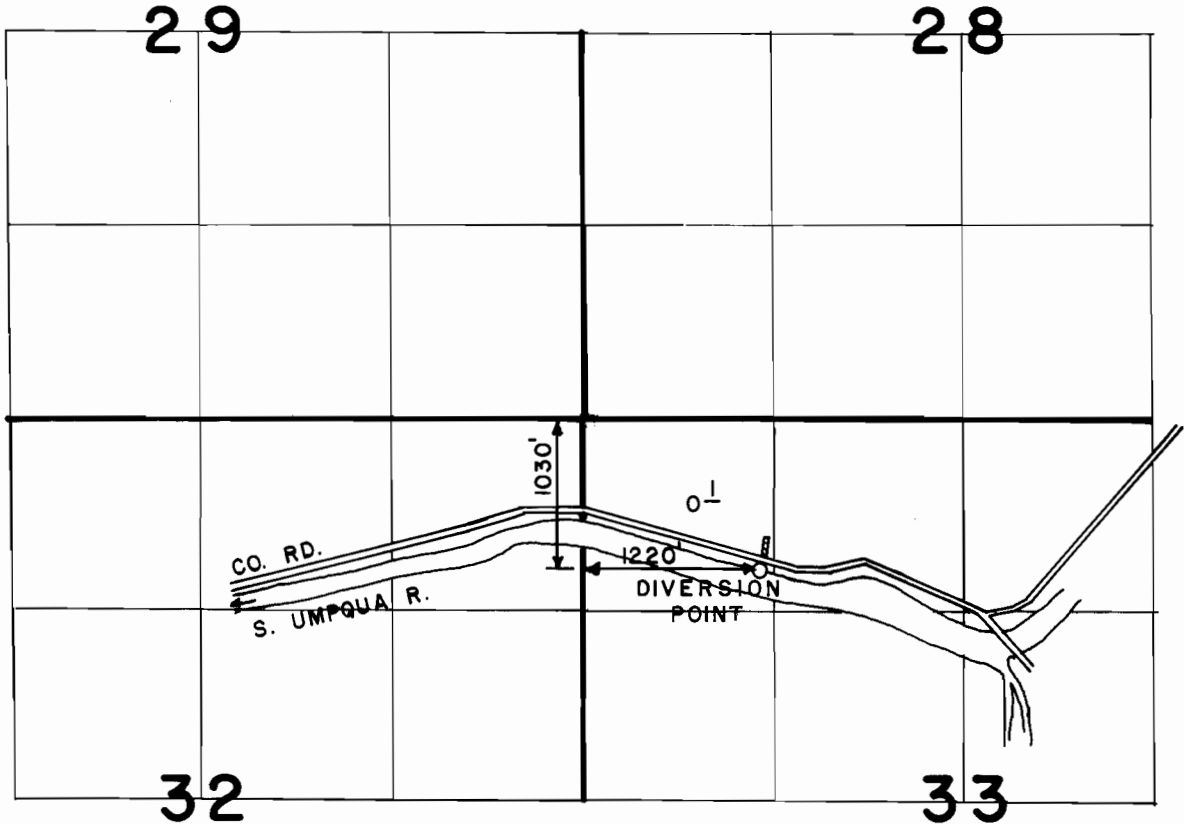

SCALE: 4" = 1 MILE

**FINAL PROOF SURVEY**  
UNDER



Application No. 68115..... Permit No. 49256.....  
IN NAME OF

**JAMES G. AND ANGELA H. HUNT**

Surveyed SEPT. 16 19.87, by J. KAUPPILA