


# T. 30 S., R. 5 W., W. M. SECTION 27

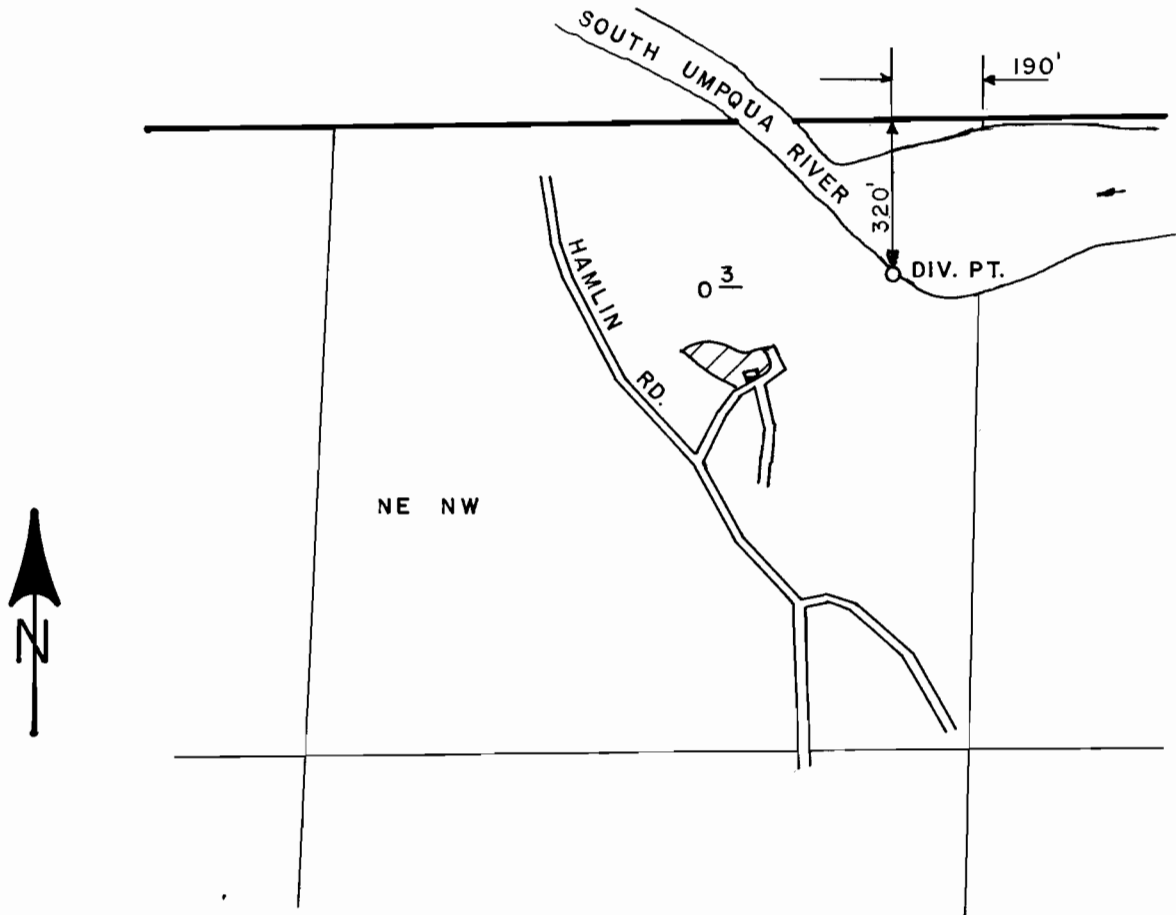

SCALE: 1" = 400'

## FINAL PROOF SURVEY UNDER

Application No. 68135 Permit No. 48755  
IN NAME OF

ARLING C. WALKER

Surveyed MAY 29, 1986, by J.M. SCHMORDE