

SKETCH MAP

LOT 1, 2, & 3, RHODODENDRON ACRE SUBD.
NW 1/4 - NE 1/4 SECTION 24, T. 40S, R. 14 W, W.M.,
CURRY COUNTY, OREGON

FOR

KARL OSTENBERG

BROOKINGS, OREGON 97415

RECEIVED


AUG 15 1984

WATER RESOURCES DEPT
SALEM, OREGON


BY

BAND D SURVEYS, Ltd.
411 MILL BEACH ROAD
BROOKINGS, OREGON 97415
PHONE (1-503) 469-5329

Application No. 68155
Permit No. 48834

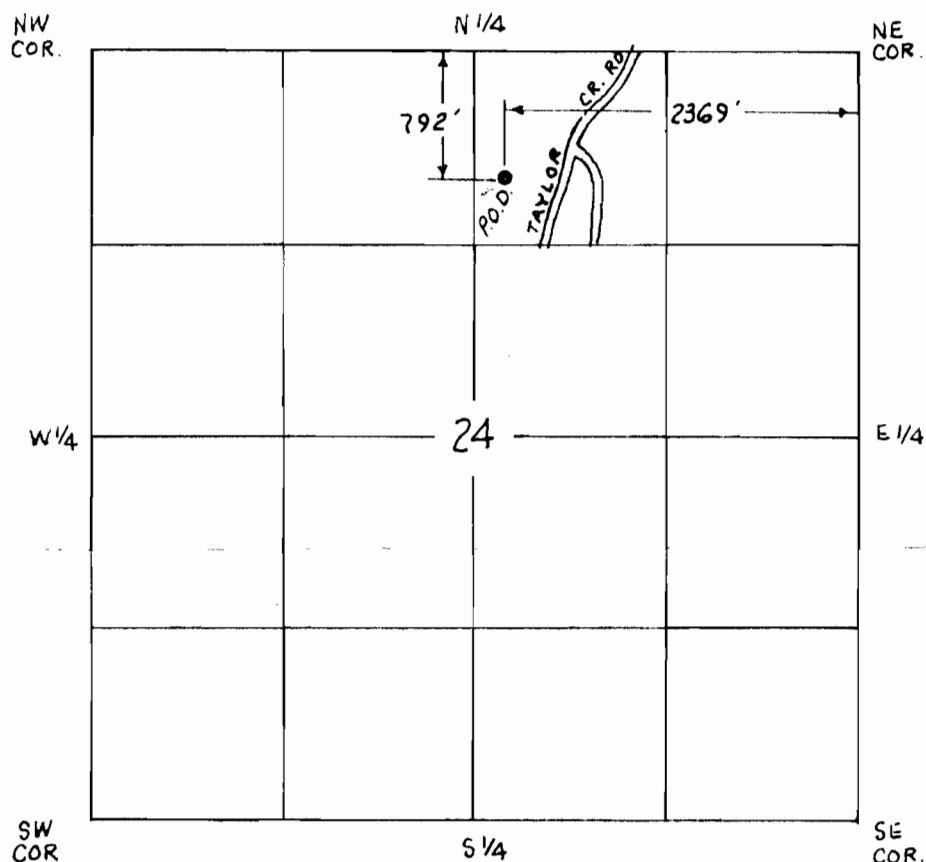

POINT OF DIVERSION - S. 792' & W. 2369'
FROM THE NE COR. SECTION 24, T. 40S, R. 14W, W.M.,

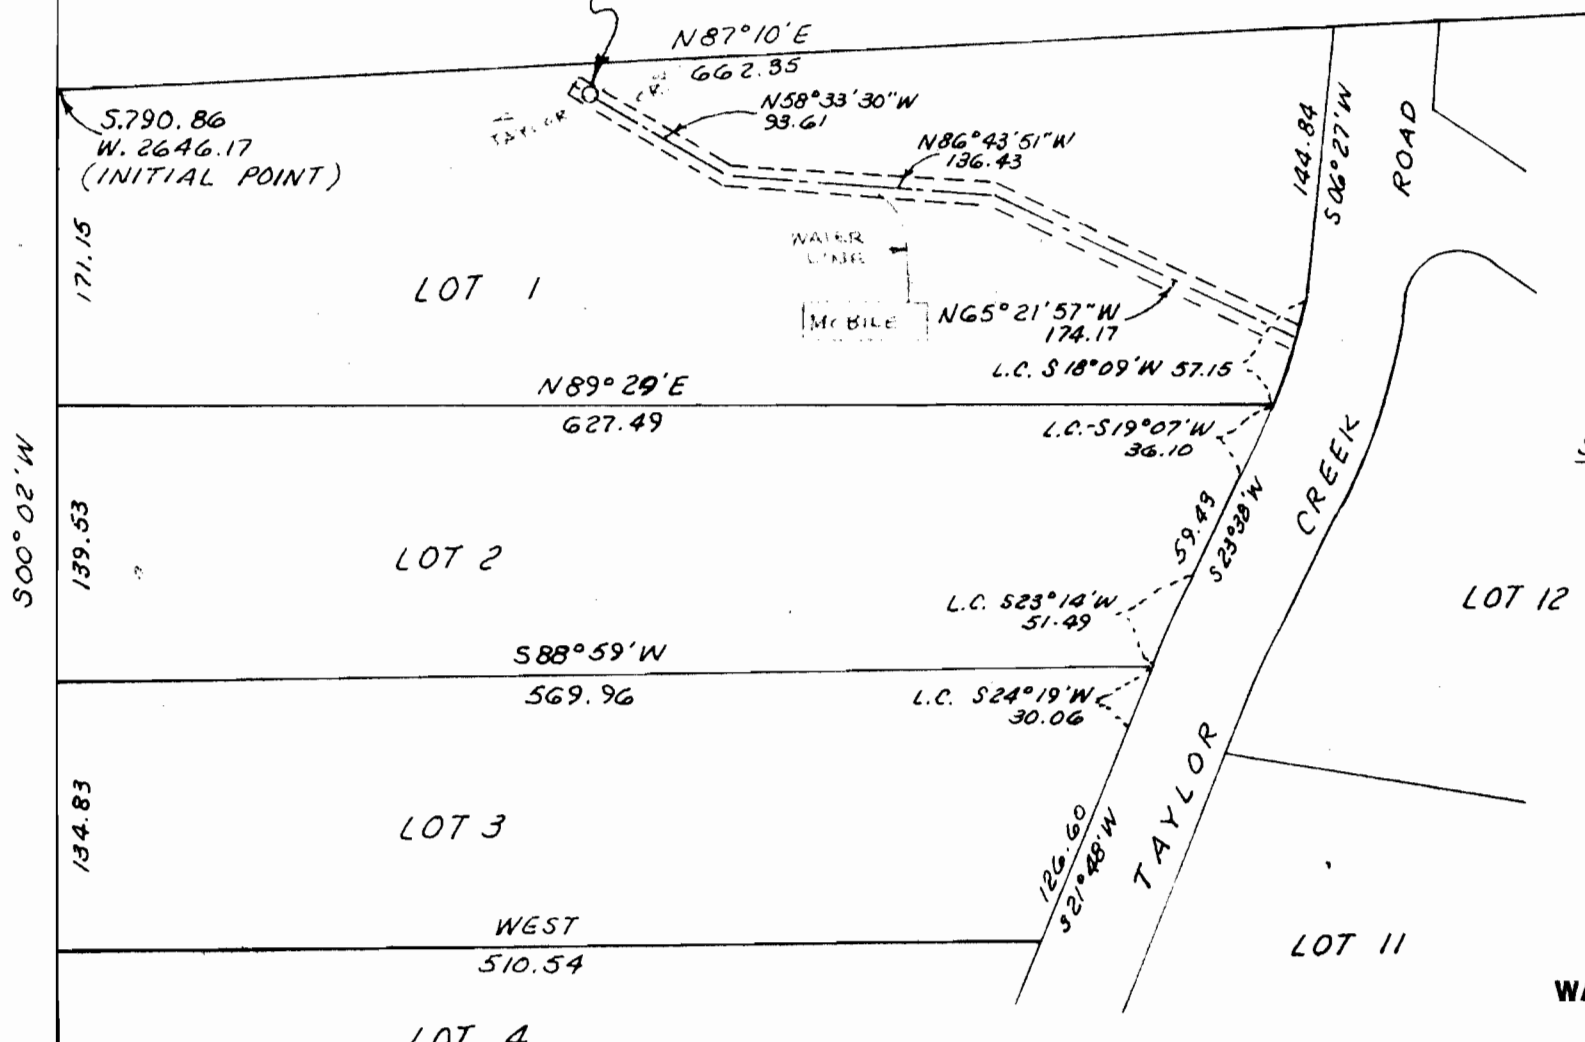

SCALE 1" = 100'

RECEIVED

AUG 10 1984

WATER RESOURCES DEPT
SALEM, OREGON